

KANSAS

FORM 51 5M 4-41 PETROL


Stafford

Section 10 Township 24 Range 11-W

Well No. #8 Richardson

Company Stanolind

NORTH Zenith Pool

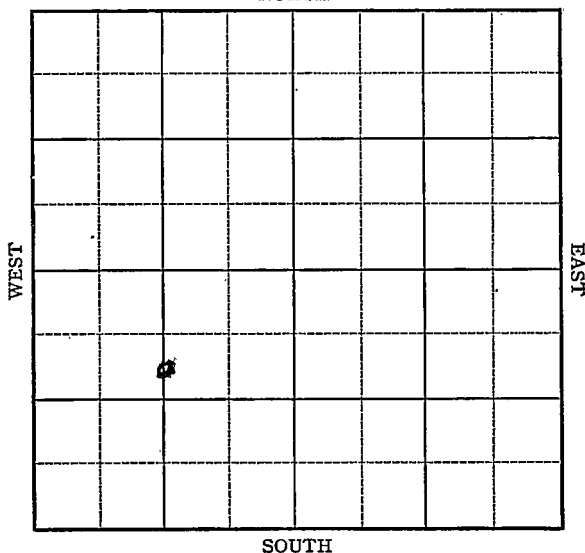

Map No. 47 Sec. 10 Twp. 24 R. 11WWell No. 8 RichardsonStanolind

Company

Contractor

FIRST REPORTC S L N $\frac{1}{2}$ SW**SECTION PLAT**

990 Ft. from N. Line

_____ Ft. from S. Line

_____ Ft. from E. Line

1320 Ft. from W. Line

ZENITH POOL

Location _____

Rig up _____

Drilling and Remarks:

Derrick

RECORD

Cased _____ in., _____ ft.

Sand _____

Gas _____

Oil _____

Total Depth _____

PRODUCTION

1st 24 hrs. Nat. _____

1st 24 hrs. after shot _____

Gas _____ Cu. Ft.

Dry Hole _____

Abandoned _____

Date

APR 30 1941.19S. J. LEWIS Scout

Map No. 47 Sec. 10 Twp. 24 R. 11W

Well No. 8 Richardson

Stanolind Company

COMPLETED Contractor

SECTION PLAT

C S L N $\frac{1}{2}$ SW

990 Ft. from N. Line

_____ Ft. from S. Line

_____ Ft. from E. Line

1320 Ft. from W. Line

ZENITH POOL

Location _____

Rig up _____

Drilling and Remarks:

Vidya 3795
5" @ 3800
3000 rods
Bond P 7865

42 6/8

RECORD

Cased _____ in., _____ ft.

Sand _____

Gas _____

Oil _____

Total Depth: 3819

PRODUCTION

1st 24 hrs. Nat. _____

1st 24 hrs. after shot _____

Gas _____ Cu. Ft.

Dry Hole _____

Abandoned _____

Date

JUN 4 1941 19

S. J. LEWIS Scout