

KANSAS

Stafford


FORM 51 5M 4-41 PETROL

Section 10 Township 24 Range 12-W

Well No. #2 Beyers

Company Cities Service Oil

Zenith Pool

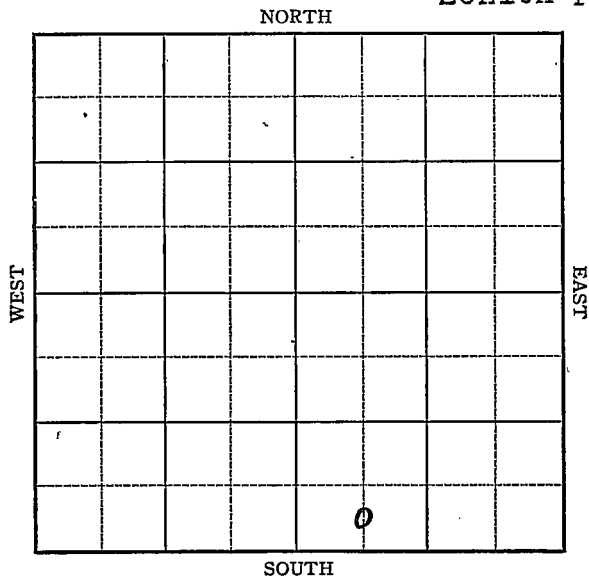

Sec. 10 Twp. 24 R. 12-W

Well No. #2 Beyers Farm

Cities Service Oil Company

(Zenith)


_____ Ft. from N. Line

330 Ft. from S. Line

_____ Ft. from E. Line

660 Ft. from W. Line

Elw 1878

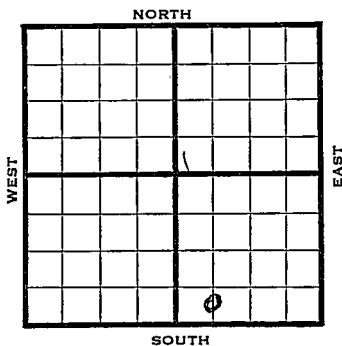

1942

REPORT

6/24 Location
 7/1 "
 7/8 "
 7/15 Drlg. 398'
 7/22 8" - 398 Drlg. 2240'
 7/29 3455'
 8/5 Lans. 3464
 Viola 3849
 T.D. 3871
 No shows.

ABANDONED

Stafford

Map No. 47 Sec. 10 Twp. 24 R. 12WWell No. 2 BeyersCities Service Oil

Company

FIRST REPORT

Contractor

C SL SW SE

SECTION PLAT

 Ft. from N. Line330 Ft. from S. Line Ft. from E. Line660 Ft. from W. Line

ZENITH POOL

Location XXRig up Drilling and Remarks:

RECORD

Cased in., ft.Sand Gas Oil Total Depth

PRODUCTION

1st 24 hrs. Nat. 1st 24 hrs. after shot Gas

Cu. Ft.

Dry Hole Abandoned

Date

JUN 24 194219S. J. LEWIS

Scout

Stafford

Map No. 77 Sec. 10 Twp. 24 R. 12WWell No. 2 Beyers

Cities Service Oil

Company

ABANDONED

Contractor

C SL SW SE

SECTION PLAT

_____ Ft. from N. Line

330 Ft. from S. Line

_____ Ft. from E. Line

660 Ft. from W. Line

6

ZENITH POOL

RECORD

Location _____

Cased _____ in., _____ ft.

Rig up _____

Sand _____

Drilling and Remarks:

Gas _____

Oil _____

Total Depth 3871*Lease 3464**Viola 3849**Nashua*

PRODUCTION

1st 24 hrs. Nat. _____

1st 24 hrs. after shot _____

Gas _____ Cu. Ft.

Dry Hole _____

Abandoned _____

Date

AUG 5 1942 19

S. J. LEWIS Scout