

KANSAS

Stafford

Section 10 Township 24 Range 14-WWell No. #1 KoelschCompany Lindas Oil etal.
Rattlesnake

NORTH

					1		
							0

WEST

EAST

SOUTH

Stafford KANSAS

Sec. 10 Twp. 24 R. 14W ✓

Well No. #1 Koelsch Farm

Lindas Oil et al Company

Rattlesnake

Contractor


990' Ft. from N. Line

Ft. from S. Line

330' Ft. from E. Line

Ft. from W. Line

SE NE SE

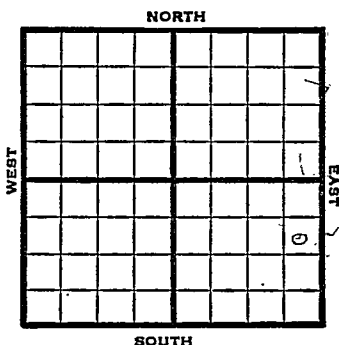

1950

Elev. 1950' REPORT

3/1

Location

4/12

TD 4243'

8" @ 222'

Cong 3988'

Viola 4028'

Simp 4158'

Arb. 4213'

5" @ 4240'

Plug back 3800'

Perf 36/3760-70

252 BOPD

Comp

COMPLETED

Sd-
v
s
h

Map No. _____ Sec. 10 Twp. 24 R. 14WWell No. 1 KoelschLindas Oil etal.

Company

Contractor

SE NE SE

El. 1950


SECTION PLAT

990 Ft. from N. Line

_____ Ft. from S. Line

330 Ft. from E. Line

_____ Ft. from W. Line

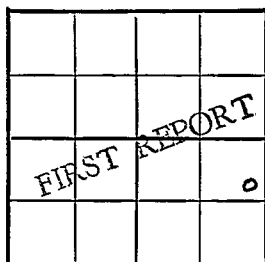

Stafford County

Location X

Rig up _____

Drilling and Remarks:

RECORD

Cased _____ in., _____ ft.

Sand _____

Gas _____

Oil _____

Total Depth _____

PRODUCTION

1st 24 hrs. Nat. _____

1st 24 hrs. after shot _____

Gas _____ Cu. Ft.

Dry Hole _____

Abandoned _____

Date

MAR 1 1950

19

J. E. TYRA


Scout

Kansas

Map No. _____ Sec. 10 Twp. 24 R. 14WWell No. 1 KoelschLindas Oil etal. Company

Contractor

SE NE SE

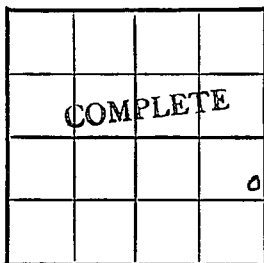E. 1950
SECTION PLAT990 Ft. from N. Line Ft. from S. Line330 Ft. from E. Line Ft. from W. Line

Stafford County

Location _____

Rig up _____

Drilling and Remarks:

8" @ 22' 2"
 Cong 3988
 Viola 4028
 Simp 4158
 Arb 4213
 5' @ 4240
 Plug Back 3800

Date

(over)

RECORD

Cased _____ in., _____ ft.

Sand _____

Gas _____

Oil _____

Total Depth 4243

PRODUCTION

1st 24 hrs. Nat. _____

1st 24 hrs. after shot _____

Gas _____ Cu. Ft.

Dry Hole _____

Abandoned _____

APR 12 1950 19

J. E. TYRA Scout

per 36/3760-70

252 BOPD

TA 62 22

0800-7


APR 21 1950

Scout Cards edit
Land Small Map 1
Land Wall Map 1
Tracings 1
France Map 1
Pierce Map 1
Misc. 1

and