


Section 10 Township 24 Range 14 W

Well No. # 1 Davis

Company Lion Oil Co.

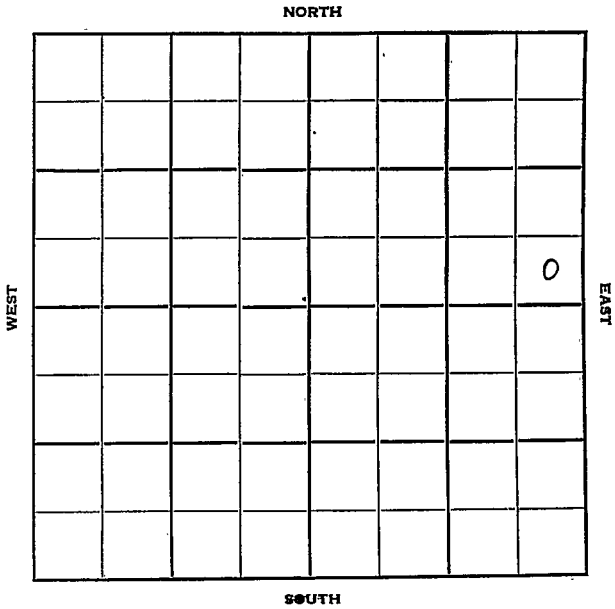

Stafford

KANSAS

Sec. 10 Twp. 24 R. 14 W ✓

Well No. # 1 Davis Farm

Lion Oil Company Company


Rattlesnake Pool Contractor

_____ Ft. from N. Line

330 Ft. from S. Line

330 Ft. from E. Line

_____ Ft. from W. Line

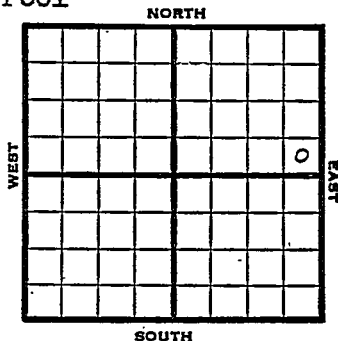

SE SE NE

1951 Elev. 1955' REPORT

7/3 Location

8/29 Spud 7-9-51
 Oil well TD 4046' 9" @ 260
 Heeb 3489' Br. lime 3625'
 Lans. 3642'
 DST 3770-83 open 1 hr. rec 65' OCM
 DST 3814-23 open 1 hr. rec 45' SOCM
 Cong 4015' Viola 4030-34
 5" @ 4030 TD 4046' B/15' gassy oil
 Hydrofrac S/4 BOPH P/3 BOPH
 Comp. 140 BOPD 3% water

COMPLETED

