


Section 10 Township 24 Range 15W

Well No. #1 Nagel

Company Vickers Expl. Ltd.

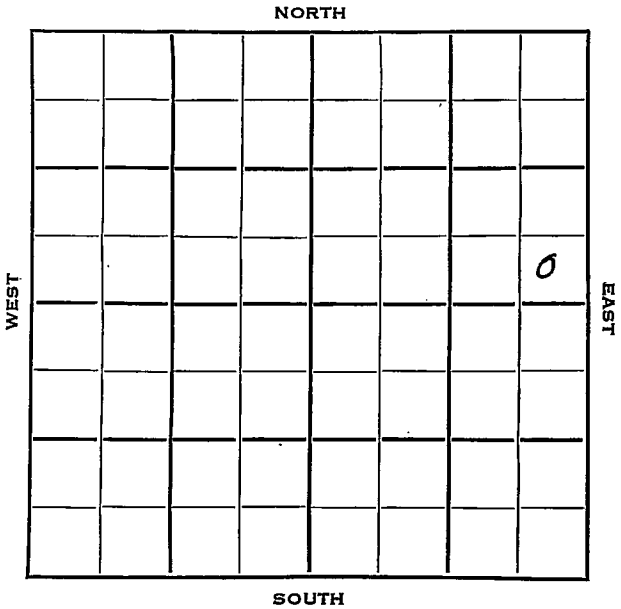

Stafford

KANSAS ✓

Sec. 10 Twp. 24 R. 15W

Well No. #1 Nagel Farm

Vickers Expl. Ltd. Company


Jayhawk
Wildcat. Contractor

Ft. from N. Line

330 Ft. from S. Line

330 Ft. from E. Line

Ft. from W. Line

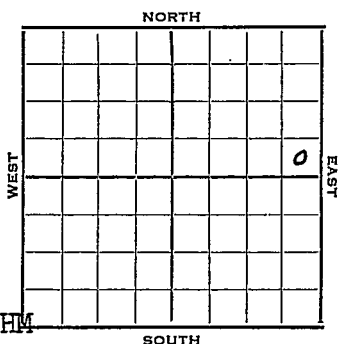

SE SE NE

CSO Acreage & Amerado-DHM


1953 Elev. 2025' REPORT

7/8 C & P
7/22 8" @ 231'
Anhy 945, Heeb 3464, Tor 3482, Dodge 3500, Br. L. 3598, Lans 3606
DST 3767-80 1 hr, 60' OCM, 1100#
Cong 3968, V. 3999
DST 4001-19 3/4 hr, 10' M, 38#
Simp 4017, Arb 4032.
7/29 Spud 7-8-53
D&A
TD 4097
8" @ 231'
Anhy 945, Heeb 3464, Tor 3482, Dodge 3500, Br lime 3598, Lans 3606
DST 3767-80, opn 1 hr., rec. 60' ocm, 1100#
Cong 3968, Viola 3999
DST 4001-19, opn 3/4 hrs., rec. 10' mud 38#
Simp 4017, Arb 4032, Granite 4095
DST 4007-37, opn 1 hr., rec. 35' mud, 215#
DST 4037-47', opn 1 1/2 hrs., rec. 25' mud 255#
DST 4037-97, opn 1 hr., rec. 40' mud, 200#
TD 4097
D&A

ABANDONED

County **Stafford** State **Kansas**
 Sec. **10** (Blk. Twp.) **24** (Sur. Rge.) **15W** Map No.
 Operator **Vickers Expl., Ltd.**
 Well No. **1** Farm **Nagel**

Elev. Location **SE SE NE**

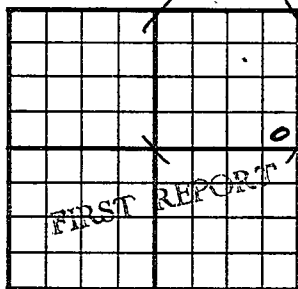

330 Ft. From **S** Line **NE**

330 Ft. From **E** Line Quarter

Ist. Report **JUL 8 1953**

Completion

Remarks **CSO Acreage & Amerado-**

Jayhawk-Contr.

Spudding Date


Drlg. Data

Wildcat

G & P

J. G. McGEHEE

County Stafford State Kansas
 Sec. 10 (Blk. 24) (Sur. 15W) Map No. 15W
 Operator Vickers Expl. Ltd.
 Well No. 1 Farm Nagel
 Elev. 2025 Location SE SE NE

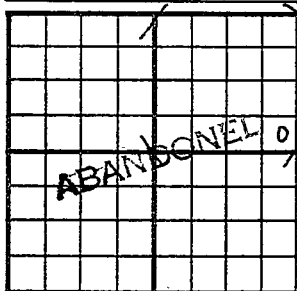

330 Ft. From S Line NE
330 Ft. From E Line Quarter
 1st. Report JUL 29 1953
 Completion Wildcat
 Remarks Jayhawk - Contr.
 Spudding Date 7-8-53

Drlg. Data D & A TD 4097
8" @ 231 Anhy 945 Heeb. 3464
Tor. 3482 Dodge 3500 Br. lime 3598
Lans. 3606 DST 3767-80 open 1 hr.
Rec. 60' ocm 1100# Cong. 3968
Viola 3999 DST 4001-19 open 3/4 hr.
Rec. 10' mud 38# Simp. 4017
Arb. 4032 Granite 4095 DST 4007-37
open 1 hr. Rec. 35' mud 215# DST 4037-
47 open 1 1/2 hr. Rec. 25' mud 255#
DST 4037-97 open 1 hr. Rec. 40' mud
200# TD 4097

D & A

J. G. McGEHEE

WILDCAT

S-513-B

County Stafford Elev. 2025 DF
 Sec. 10 Twp. 24 Rge. 15W
 Company Wilkinson Drlg.
 Farm Name Nagel No. 1

TOPS	DEPTH	LOG	DATUM
Anh.			
Tp.			
H.			
Tr.			
Dg.			
B.L.			
L. <u>K</u>	<u>3606</u>		
K.C.			
B.K.C.			
Ce.			
C.	<u>3968</u>		
M.			
M.			
K.			
Mz.			
Mq.			
V.	<u>3999</u>		
S.	<u>4017</u>		
S.			
A.	<u>4032</u>		
<u>K Granite</u>	<u>4095</u>		
Pf.			
G.			
T.D.			

Loc. in Sec. _____

SE SE NE

(O.W.W.O.)


O.W.W.O.

Geol. _____

Contr. _____

Pool _____

Wildcat

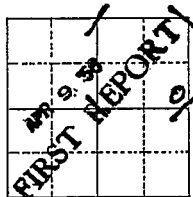

Date Comm. _____ (CRA - BHM & DHM)

OLD INFO? Tops. OTD 4097, D & A 7/29/58.

NEW INFO: MIR, CO 4100' TD, 4" @ 3895,

w/150, WOCT.