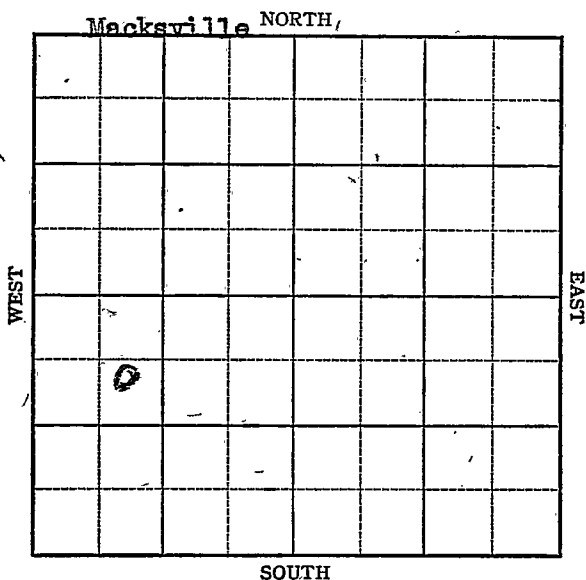


KANSAS

Stafford

FORM 51 IOM 12-46 PETROL

Section 10 Township 24 Range 15WWell No. 1 SmithCompany Huber Oil

KANSAS

Stafford County ☒

Sec. 10 Twp. 24 R. 15-W ☒

Well No. 1 Smith Farm

Huber Oil Company

Macksville Pool

NORTH


700 Ft. from N. Line

Ft. from S. Line

Ft. from E. Line

760 Ft. from W. Line

C NW SW

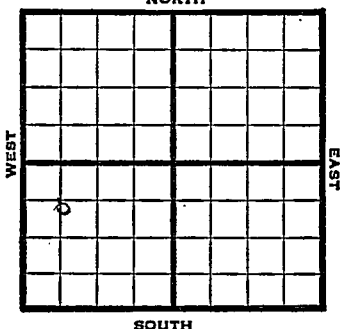

1947

Elev. REPORT 2026'

7/30

Derrick

8/6

Surface hole

8/13

8" @ 903'
Drlg. 2336'

8/20

Drlg 3606'

8/27

Lans. 3684'
Viola 4052'
Arbuckle 4168'
Total Depth 4218'

ABANDONED

KANSAS


Map No. _____ Sec. 10 Twp. 24 R. 15WWell No. 1 SmithHuber Oil Company

FIRST REPORT

Contractor _____

C NW SW

SECTION PLAT

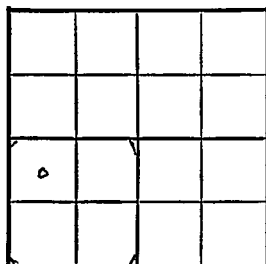700 Ft. from N. Line

_____ Ft. from S. Line

_____ Ft. from E. Line

760 Ft. from W. Line

Stafford County

Location _____

Rig up _____

Drilling and Remarks:

Derrick

RECORD

Cased _____ in., _____ ft.

Sand _____

Gas _____

Oil _____

Total Depth _____

PRODUCTION

1st 24 hrs. Nat. _____

1st 24 hrs. after shot _____

Gas _____ Cu. Ft.

Dry Hole _____

Abandoned _____

Date


JUL 30 1947 19S. J. LEWIS Scout

Kansas

Map No. 83 Sec. 10 Twp. 24 R. 15WWell No. 1 SmithHuber Oil Company**ABANDONED**

Contractor

C NW SW

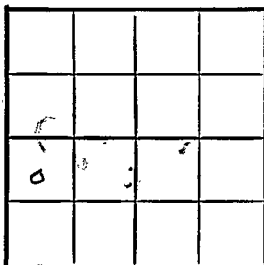E12026
SECTION PLAT700 Ft. from N. Line Ft. from S. Line Ft. from E. Line760 Ft. from W. LineStafford CountyLocation Rig up

Drilling and Remarks:

*Lane 3684**Vula 4052**Or 44168***RECORD**Cased in., ft.Sand Gas Oil Total Depth 4218**PRODUCTION**1st 24 hrs. Nat. 1st 24 hrs. after shot Gas Cu. Ft.Dry Hole Abandoned

Date

AUG 27 1947 19 S. J. LEWIS Scout