

KANSAS

FORM 51 5M 10-41 PETROL


Stafford

Section 10 Township 24 Range 15-W

Well No. #1Walker


Company Cities Service Oil

Wildcat

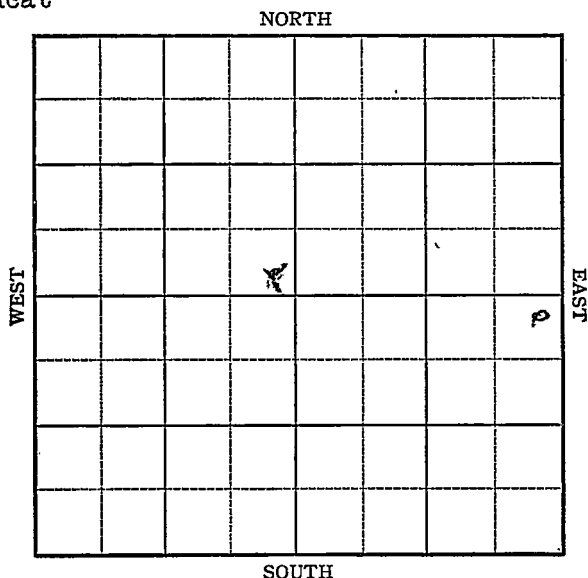

Sec. 10 Twp. 24 R. 15WWell No. 1-Walker FarmCities Service Oil Company
(Wildcat)330 Ft. from N. Line Ft. from S. Line330 Ft. from E. Line Ft. from W. Line

Elev. 2023

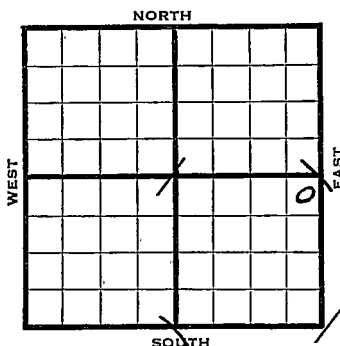

1942

REPORT

9/23 Location
9/30 Drlg. 1965'
10/7 Drlg. 3240
10/14 Drlg. 4030'
10/21 Arb. 4044
T.D. 4160'
Water.

ABANDONED

Map No. 83 Sec. 10 Twp. 24 R. 15W

Well No. 1 Walker

Cities Service Oil Company
FIRST REPORT
Contractor

NE SE


SECTION PLAT

330 Ft. from N. Line

_____ Ft. from S. Line

330 Ft. from E. Line

_____ Ft. from W. Line

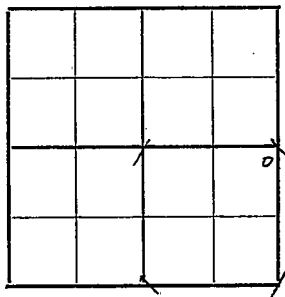

WILDCAT

Location XXX

Rig up _____

Drilling and Remarks: _____

RECORD

Cased _____ in., _____ ft.

Sand _____

Gas _____

Oil _____

Total Depth _____

PRODUCTION

1st 24 hrs. Nat. _____

1st 24 hrs. after shot _____

Gas _____ Cu. Ft.

Dry Hole _____

Abandoned _____

Date

SEP 23 1942 19 S. J. LEWIS Scout

Stafford **KANSAS**Map No. 83 Sec. 10 Twp. 24 R. 15WWell No. 1 WalkerCities Service Oil CompanyABANDONED Contractor

NE SE

SECTION PLAT

330 Ft. from N. Line Ft. from S. Line330 Ft. from E. Line Ft. from W. Line

			6

WILDCAT

Location Rig up

Drilling and Remarks:

Cer 84044Water

RECORD

Cased in., ft.Sand Gas Oil Total Depth 4160

PRODUCTION

1st 24 hrs. Nat. 1st 24 hrs. after shot Gas Cu. Ft.Dry Hole Abandoned

Date

OCT 21 1942 19S. J. LEWIS Scout