

Edwards


KANSAS

DX 78-1

Section 30 Township 24 Range 16W

Well No. #1 Kirkman

Company Branine & Holl

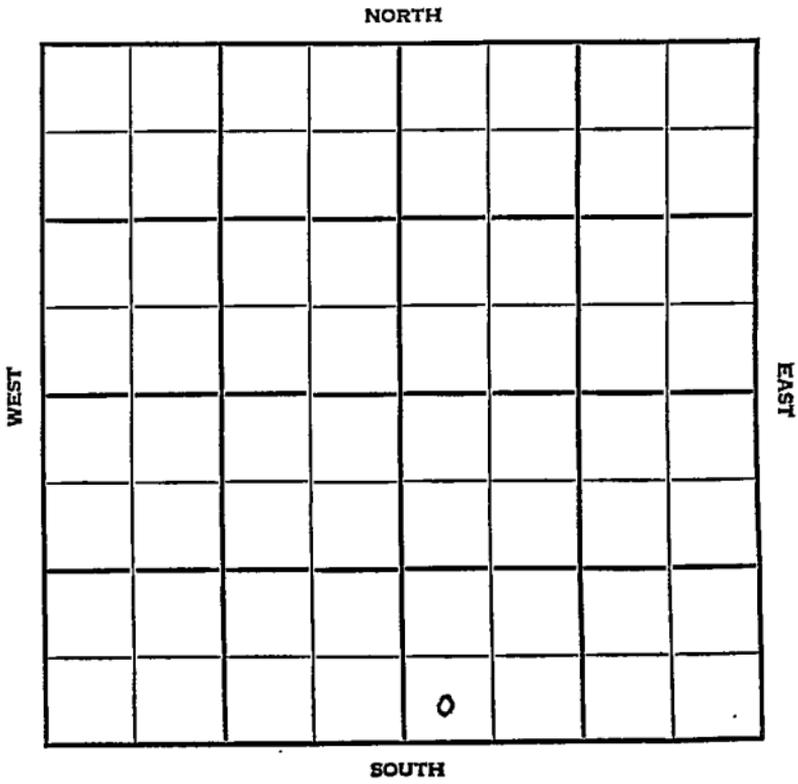

Edwards

KANSAS

SEC.	TWP.	R.
10	24	16W

WELL NO. #1 Kirkman FARM

COMPANY Branine & Holl

CONTRACTOR // Herndon Drlg.


Wildcat.

_____ Ft. from N. Line

330 _____ Ft. from S. Line

_____ Ft. from E. Line

330 _____ Ft. from W. Line

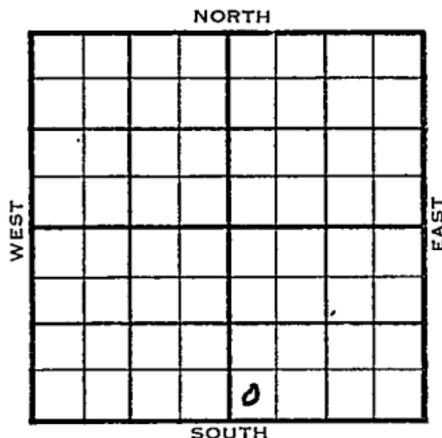

SW SW SE

1954	ELEVATION 2069'	REPORT
------	-----------------	--------

10/6 Spud 9-29-54
8" @ 249'
Anhy 1060'
Drlg. 2780'

10/20 Spud 9-29-54
D & A
TD 4399'
8-5/8" @ 249'
Anhy 1060', Heeb 3646', Br. Lime 3782'
Lans 3788', Cong 4195', Miss 4269'
Viola 4358'
TD 4399'
DST 4271'-4336' opn 1 hr, rec 16' Mud
650#
D & A

ABANDONED

Map No. _____ Sec. 10 Twp. 24 R. 16W

Well No. 1 Kirkman

Branine & Holl Company

CORRECTION Contractor

SW SW SE

SECTION PLAT

_____ Ft. from N. Line

330 Ft. from S. Line

_____ Ft. from E. Line

330 Ft. from W. Line

Edwards County

Location _____

Rig up _____

Drilling and Remarks:

~~Reported
Herrion Drlg.~~

RECORD

Cased _____ in., _____ ft.

Sand _____

Gas _____

Oil _____

Total Depth _____

PRODUCTION

1st 24 hrs. Nat. _____

1st 24 hrs. after shot _____

Gas _____ Cu. Ft.

Dry Hole _____

Abandoned _____

Date

OCT 6 1954

FABEN GILSTRAP
Scout

