


Section 10 Township 24 Range 33W

Well No. #1 Burt

Company Northern Pump

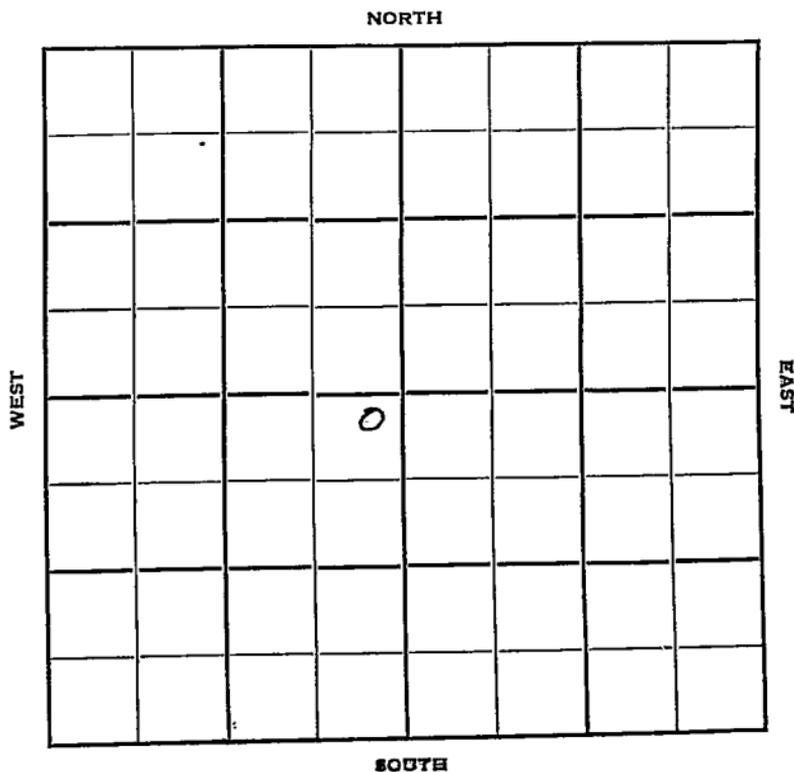

Sec. 10 Twp. 24 R. 33W

Well No. #1 Burt Farm _____

Northern Pump Company _____

Hugoton Pool Contractor _____


150 Ft. from N. Line

_____ Ft. from S. Line

150 Ft. from E. Line

_____ Ft. from W. Line

NE SW

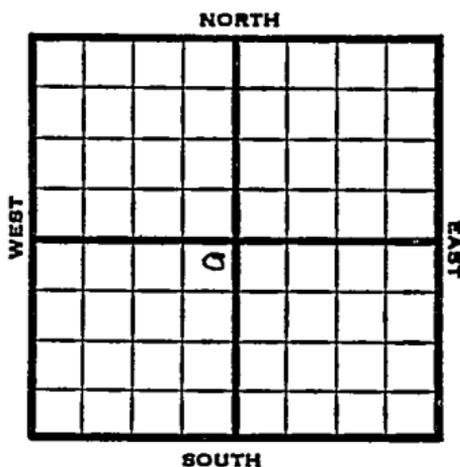

1952

Elev. 2867 REPORT

11/12 Location

11/20 8" @ 359
Drlg. 2250'

11/27 NR
12/4 "

12/11 Ker 2513 Kreder 2538 Winfield 2575
RTD 2585 5" @ 2580

12/18 NR

12/25 NR

1/1 CO Coring 2551
1/8 CO 2568 32/2526-34 40/2548-58
5000A 146/2526-58 DD 2569

1/22 NR
1/29 3000 A

2/5 500A

2/11 Spudding Date 11/10/52
Gas well TD 2569
8" @ 359 Her. 2513 Kri 2538
Win. 2575 TD 2585 5" @ 2580 CO to 2551
CO to 2568 32/2526-34 4-/2548-58
5000 A 146/2526-58 DD 2569 17500A
Comp. 6,750,000 gas 296#.

COMPLETED

