

KANSAS


Form 51—5M—7-39—Palace

Stafford

Section 11 Township 24 Range 11-W

Well No. #9 Fuller

Company Stanolind

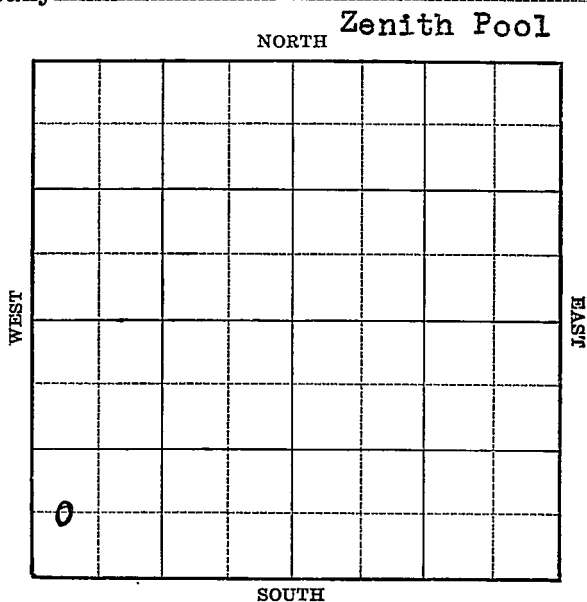

KANSAS


Stafford

Sec. 11 Twp. 24 R. 11-WWell No. #9 Fuller FarmStanolind Company

(Zenith)

 Ft. from N. Line660 Ft. from S. Line Ft. from E. Line330 Ft. from W. Line

Elev. 1809

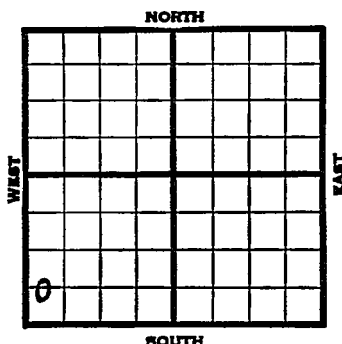

1940	REPORT
1/3	Location
1/11	"
1/18	R.U.R.
1/25	10" - 254'
	Drlg. 753'
2/1	Drlg. 2977'
2/8	Misener 3749'
	Coring 3752'
2/15	Viola 3782' SO 3795-3801'
	T.D. 3810' 7" - 3749' RUST.
2/23	Testing.
2/28	Misener 3749'
	Viola 3782'
	7" - 3749'
	T.D. 3822'
	3000 acid.
	Bomb potential 1194 bbls.
	COMPLETED

Map No. 47 Sec. 11 Twp. 24 R. 11WWell No. 9 FullerStanolind

Company

Contractor

~~FIRST REPORT~~C $W\frac{1}{2}$ SW SW

SECTION PLAT

D			

 Ft. from N. Line660 Ft. from S. Line Ft. from E. Line330 Ft. from W. Line

ZENITH POOL

Location XRig up Drilling and Remarks:

RECORD

Cased in., ft.Sand Gas Oil Total Depth

PRODUCTION

1st 24 hrs. Nat. 1st 24 hrs. after shot Gas Cu. Ft.Dry Hole Abandoned

Date

Jan 10 1919WIS Scout

Map No. 47 Sec. 11 Twp. 24 R. 11WWell No. 9 FullerStanolind

Company

Contractor

COMPLETEDC $W\frac{1}{2}$ SW SW**SECTION PLAT**

0			

 Ft. from N. Line660 Ft. from S. Line Ft. from E. Line330 Ft. from W. Line**ZENITH POOL**Location Rig up Drilling and Remarks: *Musnel 3749**Vida 3782**7" @ 3749**3000 acid**Bon & P. &.**1194***RECORD**Cased in., ft.Sand Gas Oil Total Depth 3822**PRODUCTION**1st 24 hrs. Nat. 1st 24 hrs. after shot Gas Cu. Ft.Dry Hole Abandoned

Date

FEB 28 1940 19S. J. LEWIS Scout