

Form 51-5M-7-39-Palace


Stafford

Section 11 Township 24 Range 11-W

Well No. #8 Harbeson

Company **Stanolind**

NORTH Zenith Pool

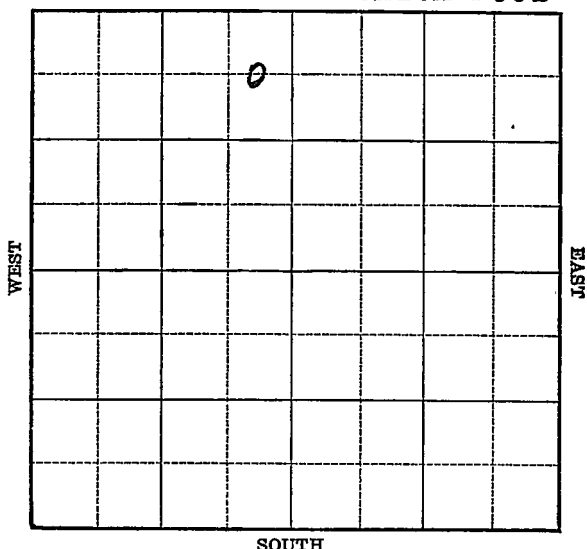

Stafford **KANSAS**Map No. 47 Sec. 11 Twp. 24 R. 11WWell No. 8 HarbesonStanolind

Company

FIRST REPORT

Contractor

SECTION PLAT**C E L NE NW**.660 Ft. from N. Line Ft. from S. Line330 Ft. from E. Line Ft. from W. Line

	0		

ZENITH POOLLocation XRig up

Drilling and Remarks:

RECORDCased in., ft.Sand Gas Oil Total Depth **PRODUCTION**1st 24 hrs. Nat. 1st 24 hrs. after shot Gas Cu. Ft.Dry Hole Abandoned

Date

MAR 13 1940 19S. J. LEWIS Scout

Map No. 47 Sec. 11 Twp. 24 R. 11WWell No. 8 HarbesonStanolind

Company

Contractor

COMPLETED

C E L NE NW

660 Ft. from N. Line

Ft. from S. Line

330 Ft. from E. Line

Ft. from W. Line

ZENITH POOL**SECTION PLAT**

Location _____

Rig up _____

Drilling and Remarks:

*Mine 3687**Vista 3718**7" @ 3688**3000 acid**Box & P 8 11760**Maximum 3000***RECORD**

Cased _____ in., _____ ft.

Sand _____

Gas _____

Oil _____

Total Depth 3262**PRODUCTION**

1st 24 hrs. Nat. _____

1st 24 hrs. after shot _____

Gas _____ Cu. Ft.

Dry Hole _____

Abandoned _____

Date

APR 24 1940 19S. J. LEWIS Scout