

# KANSAS

Form 51-5M-7-39-Palace


Stafford

Section 11 Township 24 Range 11-W

Well No. #4 R. Harbeson

Company Stanolind

NORTH Zenith Pool

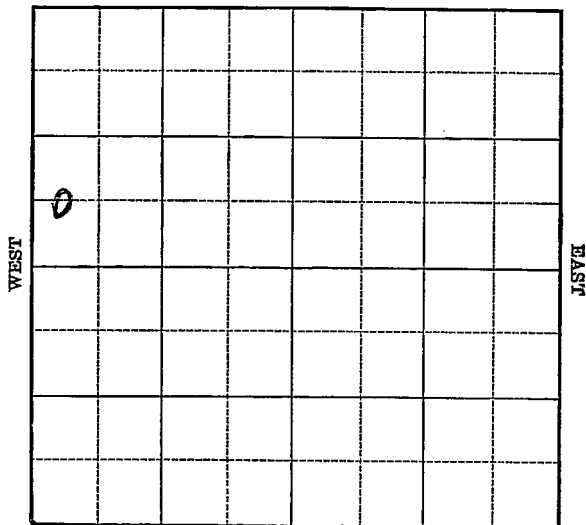

SOUTH

Sec. 11 Twp. 24 R. 11-W

Well No. #4 R. Harbeson Farm

Stanolind Company

(Zenith)


         Ft. from N. Line

660 Ft. from S. Line

         Ft. from E. Line

330 Ft. from W. Line

Elev. 1812

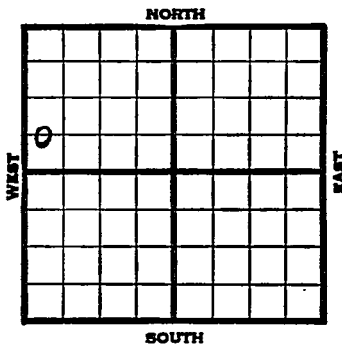

| 1939  | REPORT                       |
|-------|------------------------------|
| 10/18 | Location                     |
| 10/26 | 10" - 244' WOC.              |
| 11/2  | Drlg. 2805'                  |
| 11/9  | Misener 3734' T.D. 3738'     |
|       | Run 6".                      |
| 11/16 | " "                          |
| 11/22 | Misener 3734'                |
|       | 6" - 3734'                   |
|       | Viola 3763'                  |
|       | T.D. 3773'                   |
|       | 3000 acid.                   |
|       | Bottom hole bomb pot. 16,688 |
|       | Maximum 5000 bbls.           |
|       | <b>COMPLETED</b>             |

Map No. 47 Sec. 11 Twp. 24 R. 11W

Well No. 4 R. Harbeson

Stanolind Company

Contractor

**FIRST REPORT**

**C W $\frac{1}{2}$  SW NW**

\_\_\_\_\_ Ft. from N. Line

660 Ft. from S. Line

\_\_\_\_\_ Ft. from E. Line

330 Ft. from W. Line

**SECTION PLAT**

|   |  |  |  |
|---|--|--|--|
|   |  |  |  |
| o |  |  |  |
|   |  |  |  |
|   |  |  |  |

**ZENITH POOL**

Location X

Rig up \_\_\_\_\_

Drilling and Remarks:

**RECORD**

Cased \_\_\_\_\_ in., \_\_\_\_\_ ft.

Sand \_\_\_\_\_

Gas \_\_\_\_\_

Oil \_\_\_\_\_

Total Depth \_\_\_\_\_

**PRODUCTION**

1st 24 hrs. Nat. \_\_\_\_\_

1st 24 hrs. after shot \_\_\_\_\_

Gas \_\_\_\_\_ Cu. Ft.

Dry Hole \_\_\_\_\_

Abandoned \_\_\_\_\_

Date

OCT 18 1939 19

**S. J. LEWIS**

Scout

Map No. 47 Sec. 11 Twp. 24 R. 11W

Well No. 4 R. Harbeson

**Stanolind**

Company

Contractor

**COMPLETED**

**C W $\frac{1}{2}$  SW NW**

\_\_\_\_\_ Ft. from N. Line

660 Ft. from S. Line

\_\_\_\_\_ Ft. from E. Line

330 Ft. from W. Line

**SECTION PLAT**

|   |  |  |  |
|---|--|--|--|
|   |  |  |  |
| 0 |  |  |  |
|   |  |  |  |
|   |  |  |  |

**ZENITH POOL**

Location \_\_\_\_\_

Rig up \_\_\_\_\_

Drilling and Remarks:

*Mucier 3734*  
*6" C 3734*  
*Vidite 3763*  
*3000 acid*  
*Bottom Hole Bore*  
*16688 ft*  
*Maximum 5000*

**RECORD**

Cased \_\_\_\_\_ in., \_\_\_\_\_ ft.

Sand \_\_\_\_\_

Gas \_\_\_\_\_

Oil \_\_\_\_\_

Total Depth 3733

**PRODUCTION**

1st 24 hrs. Nat. \_\_\_\_\_

1st 24 hrs. after shot \_\_\_\_\_

Gas \_\_\_\_\_ Cu. Ft.

Dry Hole \_\_\_\_\_

Abandoned \_\_\_\_\_

Date

NOV 22 1939 19

S. J. LEWIS

Scout