


Stafford KANSAS

FORM 51 5M 2-38 TPCO.

Section 11 Township 24 Range 11-W

Well No. 3 Hayes

Company Stanolind

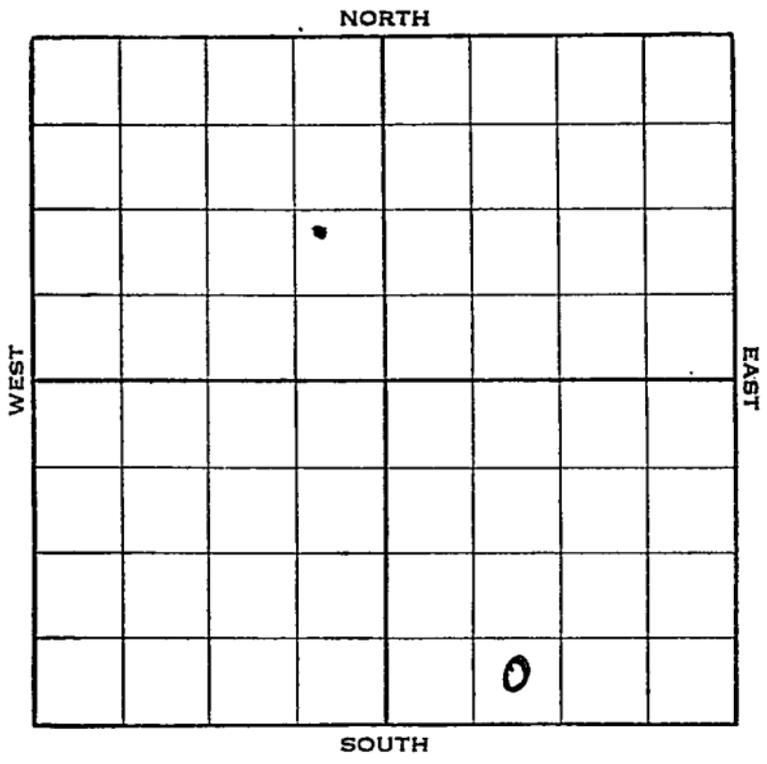

KANSAS

Stafford

Sec. 11^H Twp. 24 R. 11-W


Well No. #3 Hayes Farm
Stanolind Company

_____ Ft. from N. Line

330 Ft. from S. Line

_____ Ft. from E. Line

990 Ft. from W. Line

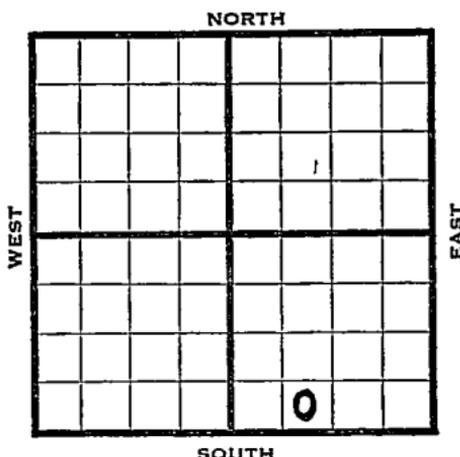

Elev. 1816

1938	REPORT
8/17	B. R. R.
8/26	R. R.
9/2	"
9/9	10" - 252'. Dlg. 350'.
9/16	Dlg. 2840'.
9/23	Lans. 3385'. Base Kinderhook 3762'. T.D. 3770'.
	6" - 3763'. RUST.
9/28	Misener 3770'.
	Viola 3776'.
	T. D. 3777'.
	Potential 2019 bbls.
	COMPLETED

Map No. 47 Sec. 11 Twp. 24 R. 11WWell No. 3 Hayes

Stanolind

Company

Contractor

FIRST REPORT

SE SW SE

110 Ft. from N. Line330 Ft. from S. Line

_____ Ft. from E. Line

990 Ft. from W. Line

SECTION PLAT

Location _____

Rig up _____

Drilling and Remarks:

BRR

RECORD

Cased _____ in., _____ ft.

Sand _____

Gas _____

Oil _____

Total Depth _____

PRODUCTION

1st 24 hrs. Nat. _____

1st 24 hrs. after shot _____

Gas _____ Cu. Ft.

Dry Hole _____

Abandoned _____

Date

AUG 17 1938 19

H. D. Hatfield Scout

Stafford **KANSAS**Map No. 47 Sec. 11 Twp. 24 R. 11WWell No. 3 HayesStanolind

Company

Contractor

COMPLETED**SECTION PLAT**SE SW SE
Ft. from N. Line330 Ft. from S. Line

Ft. from E. Line

990 Ft. from W. Line

			0

Location _____

Rig up _____

Drilling and Remarks:

RECORD

Cased _____ in., _____ ft.

Sand Misener 3770Gas 410/2 3776

Oil _____

Total Depth 3777**PRODUCTION**

1st 24 hrs. Nat. _____

1st 24 hrs. after shot _____

Gas _____ Cu. Ft.

Dry Hole _____

Abandoned _____

POT 2019

Date

SEP 28 1938 19H. D. Hatfield Scout