


Stafford KANSAS

Section 11 Township 24 Range 11-W

Well No. 1 Rebecca Sims

Company Stanolind

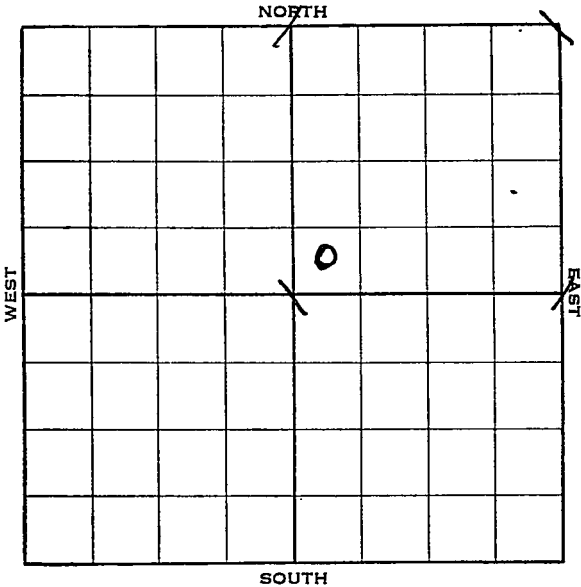


KANSAS

Stafford

Sec. 11 Twp. 24 R. 11-WWell No. #1 Rebecca Sims FarmStanolind Company Ft. from N. Line330 Ft. from S. Line Ft. from E. Line330 Ft. from W. Line

Elev. 1819

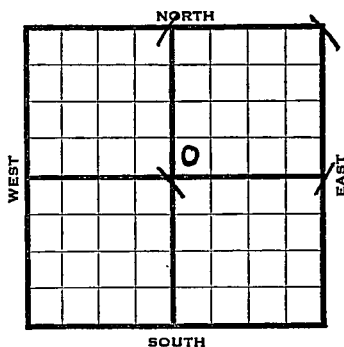

REPORT

1938

4/27

Location

5/6

R U R

5/12

10" @ 251'. Drlg. 640'.

5/20

Drlg. 2885'.

5/27

Lans. 3380'.

Base Kinderhook 3729'.

Misner 3747'. T.D. 3749'.

Show oil. Rng. 7'.

6/3

7" @ 3740'. Drilled plug.

H. F. O.

6/8

7" @ 3740'.

Misner 3747'.

T.D. 3756'.

2½" tubing.

Potential 1304 bbls., Flow.

COMPLETED


Map No. 47 Sec. 11 Twp. 24 R. 11WWell No. 1 Rebecca SimsStanolind

Company

Contractor

FIRST REPORT

SW NE

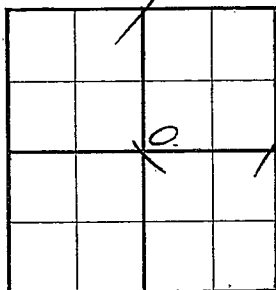SECTION PLAT Ft. from N. Line330 Ft. from S. Line Ft. from E. Line330 Ft. from W. LineLocation XRig up

Drilling and Remarks:

RECORDCased in., ft.Sand Gas Oil Total Depth **PRODUCTION**1st 24 hrs. Nat. 1st 24 hrs. after shot Gas Cu. Ft.Dry Hole Abandoned

Date

APR 27 193819H. D. Hatfield Scout

Stafford **KANSAS**Map No. 47 Sec. 11 Twp. 24 R. 11WWell No. 1 Rebecca Simsstanolind

Company

Contractor

COMPLETED

SW NE

Ft. from N. Line

330 Ft. from S. Line

Ft. from E. Line

330 Ft. from W. Line**SECTION PLAT**

		0	

Location

Rig up

Drilling and Remarks:

Pot 1304

Flow

2 1/2" Tubing

RECORDCased 7 in., 3740 ft.Sand Misener 3747

Gas

Oil

Total Depth 3756**PRODUCTION**

1st 24 hrs. Nat.

1st 24 hrs. after shot

Gas " " Cu. Ft.

Dry Hole " "

Abandoned

Date

JUN 8 - 1938 19

H. D. Hatfield

Scout