


Section 11 Township 24 Range 12 W

Well No. 4 Hildebrand

Company M. B. Armour

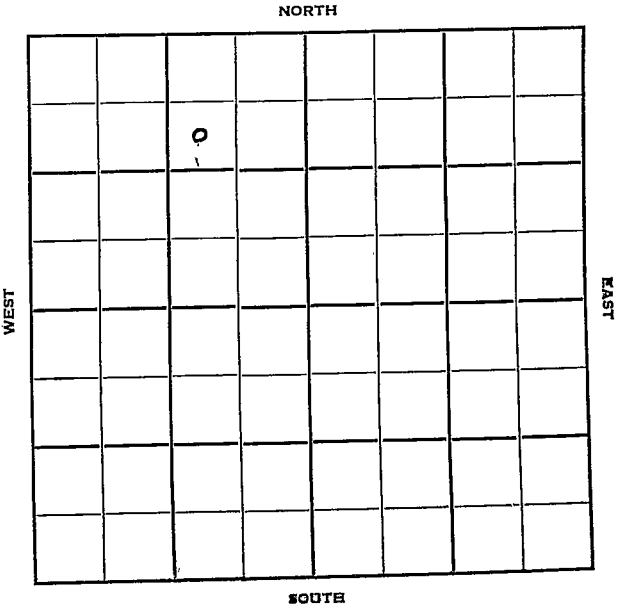

Stafford

KANSAS

Sec. 11 Twp. 24 R. 12W

Well No. #4 Hildebrand Farm

M. B. Armour Company

Contractor

990'

Ft. from N. Line


Ft. from S. Line

990'

Ft. from E. Line

Ft. from W. Line

SW NE NW

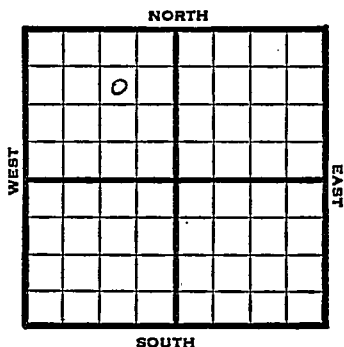

1950

Elev. 1862'

REPORT

5/17

Spud 5-11-50

8-5/8" @ 200'

Drlg. 2140'

7/5

8-5/8" @ 200'

Lans. 3437'

Viola 3810'

5" @ 3809'

TD 3813'

Acid 1000

S/46 BO 4 hrs.

Comp. 439 BOPD

m

COMPLETED

Map No. _____ Sec. 11 Twp. 24 R. 12WWell No. 4 HildebrandM. R. Armour Company

Contractor

SW NE NW

SECTION PLAT

990 Ft. from N. Line

_____ Ft. from S. Line

990 Ft. from E. Line

_____ Ft. from W. Line

	o		

FIRST REPORT

Stafford

Location _____

Rig up _____

Drilling and Remarks:

Spud 5-11-50

8 5/8 @ 200

Drlg. 2140

RECORD

Cased _____ in., _____ ft.

Sand _____

Gas _____

Oil _____

Total Depth _____

PRODUCTION

1st 24 hrs. Nat. _____

1st 24 hrs. after shot _____

Gas _____ Cu. Ft.

Dry Hole _____

Abandoned _____

Date

MAY 17 1950

19

J. E. TYRA Scout

Karnac

Map No. _____ Sec. 11 Twp. 24 R. 12WWell No. 4 Hildebrand

_____ M. B. Arner _____ Company

_____ Contractor


SW NE NW

El. 1862
SECTION PLAT990 Ft. from N. Line

_____ Ft. from S. Line

990 Ft. from E. Line

_____ Ft. from W. Line

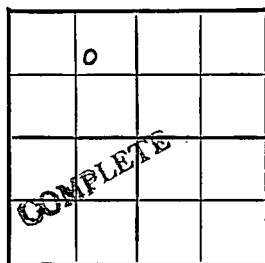

Stafford County

Location _____

Rig up _____

Drilling and Remarks:

8 5/8" @ 200

Lans. 3437

Viola 3810

5" C 3809

TD 3813

1000 acid

S/ 46 bo 4 hr.

RECORD

Cased _____ in., _____ ft.

Sand _____

Gas _____

Oil _____

Total Depth 3813

PRODUCTION

1st 24 hrs. Nat. _____

1st 24 hrs. after shot _____

Gas _____ Cu. Ft.

Dry Hole _____

Abandoned _____

Comp. 439 bopd
Date _____JUL 5 1950 19 J. E. TYRA Scout