


Section 11 Township 24 Range 13-W

Well Number 1 Gray

Company Rose Spring et al

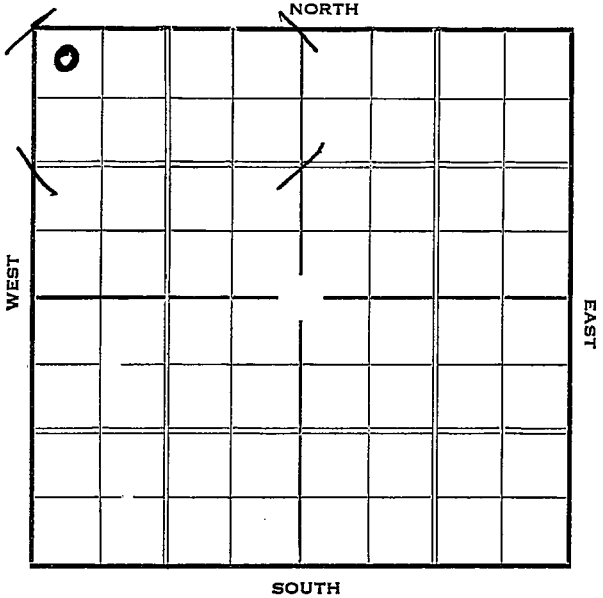


Sec. 11 Twp. 24 R. 13 WWell No. #1 Gray FarmRose Spring et al Company330 Ft. from N. Line

Ft. from S. Line

Ft. from E. Line

330 Ft. from W. Line

Elev. 1908

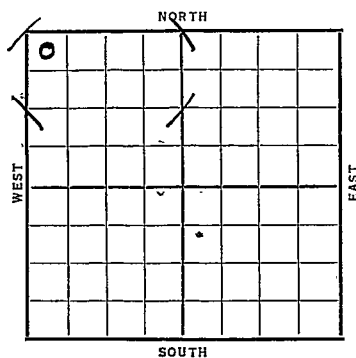Date  
1937

REPORT

2/24

R O G

3/4

" "

3/11

" "

3/18

" "

3/25

" "

4/2

" "

4/8

" "

4/16

" "

4/23

"

4/30

"

5/7

"

5/14

"

5/21

"

5/28

"

6/4

10" @ 277'. T.D. 285' SD.

6/11

" " " "

6/19

Drlg. 2890'.

6/25

K.C. 3525'? Coring 3760'.

7/2

Viola 3841'. 7" @ 3843'. S.O.

T.D. 3854'.

7/9

Bailing.

OVER

1937

7/14 7" @ 3843'.

Sil. 4030'.

T.D. 4034'.

H.F.W.

**ABANDONED**

Map No. 83 Sec. 11 Twp. 24 R. 13W.

Well No. 1 Gray

Rose Spring & Co Company

Contractor

SECTION PLAT

0			

330 Ft. from N. Line

\_\_\_\_\_ Ft. from S. Line

\_\_\_\_\_ Ft. from E. Line

330 Ft. from W. Line

FIRST REPORT

Location \_\_\_\_\_

Rig up \_\_\_\_\_

Drilling and Remarks:

ROG

0

RECORD

Cased \_\_\_\_\_ in., \_\_\_\_\_ ft.

Sand \_\_\_\_\_

Gas \_\_\_\_\_

Oil \_\_\_\_\_

Total Depth \_\_\_\_\_

PRODUCTION

1st 24 hrs. Nat. \_\_\_\_\_

1st 24 hrs. after shot \_\_\_\_\_

Gas \_\_\_\_\_ Cu. Ft.

Dry Hole \_\_\_\_\_

Abandoned \_\_\_\_\_

Date

FEB 2 1937

S. J. LEWIS Scout

KANSAS

Form 26—1M Bks.—2-29

Stafford

Map No. 83 Sec. 11 Twp. 24 R. 13<sup>w</sup>

Well No. 1 - Gray

Rose Spring et al Company  
Contractor

**ABANDONED**

**SECTION PLAT**

330 Ft. from N. Line  
\_\_\_\_ Ft. from S. Line  
\_\_\_\_ Ft. from E. Line  
330 Ft. from W. Line

0			

Location \_\_\_\_\_

Rig up \_\_\_\_\_

Drilling and Remarks:

HFW

DFA

**RECORD**

Cased 7 in., 3843 ft.  
Sand 511 4030  
Gas \_\_\_\_\_  
Oil \_\_\_\_\_  
Total Depth 4034

**PRODUCTION**

1st 24 hrs. Nat. \_\_\_\_\_  
1st 24 hrs. after shot \_\_\_\_\_  
Gas \_\_\_\_\_ Cu. Ft.  
Dry Hole \_\_\_\_\_  
Abandoned \_\_\_\_\_

Date

JUL 14 1937 19

H. D. Hatfield

Scout