


NORTH

WEST

EAST

SOUTH

Location_____

Drilling Remarks

Rig Up

Drilling Remarks

RECORD

Cased_____in. _____ft.

Sand_____

Gas_____

Oil

Total Depth_____

PRODUCTION

1st 24 hrs. Nat.-----

1st 24 hrs. after shot_____

Gas _____ cu. ft. _____

Dry Hole_____

Abandoned

Map No. KANSAS Sec. 11 Twp. 24 R. 13^w

Well No. 1-Gray Farm

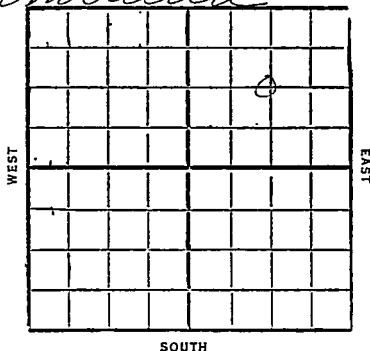
Rosenthal-Stanolind Company
& Amurda NORTH

1320 Ft. from N. Line

_____ Ft. from S. Line

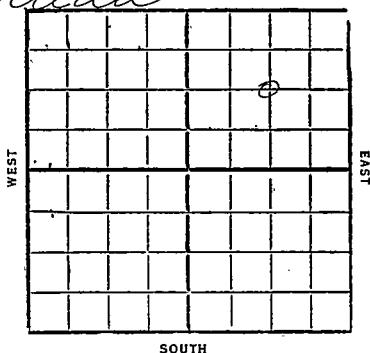
1320 Ft. from E. Line

1931 Ft. from W. Line



Date	REPORT
2/18	<u>Loc</u>
2/25	
3/4	
3/11	<u>Reg</u>
3/18	<u>Reg up</u>
3/25	
4/1	
4/8	
4/15	
4/22	<u>2 pdg 180'</u>
4/29	<u>Org 630'</u>
5/6	<u>" 1525'</u>
5/13	<u>show gas 1740-45</u>
	<u>Org 2080'</u>
5/20	<u>" 10"-2201</u>
	<u>Fishing</u>
5/27	<u>" 10"-2212</u>
	<u>Sand 2305-15 HF-W</u>
	<u>Org ahead</u>
6/3	<u>" 2415'</u>
6/10	<u>UIR 10"-2750'</u>
	(over)

6/17- 10"- 2754
Curlg 2820'
6/24- SD 2985'
7/1- HFW 3080-95
SD 3110' for 8"
7/8 —
7/15 —
7/22 —
7/29 —
8/5 —
8/12 —
8/19 —
8/26 —
9/2 —
9/9 —
9/16- Curlg 3250'
9/23- SD 3360
9/30- 8"- 3375
SD 3495
10/7 —
10/14- UIR 8"- 3495'
10/21- 8"- 3520
show out 3525-40
SD 3560
10/28 — 12/9 —
11/4 —
11/10 —
11/18 —
11/24 —
12/2 —

Map No. Kans Sec. 11 Twp. 24 R. 13^wWell No. 1- Gray FarmRosenthal & Handolind Company
& Amruda NORTH1320 Ft. from N. Line Ft. from S. Line1320 Ft. from E. Line Ft. from W. Line1931

Date

REPORT

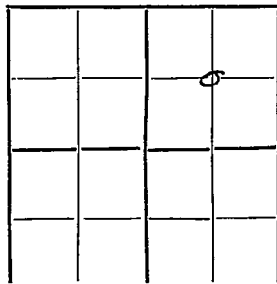
12/17 5"-3812
 Top Silic. line 3833
 Pay 3839-43
 500 ft oil in hole
 Bailed down
 Filled up 200 ft oil
 in 1 1/2 hours
 Deepened to
 T.D. 3852
 Had increase
 1000 ft oil in hole
 34⁶ grav. corrected
 STD to swab
12/18 Had 1200 ft oil in
 12 hrs at 3852
 Deepened to
 T.D. 3867
 Had 1500 ft oil
 Bailed down 300 ft
 and after standing
 12 hrs did not
 fill up.

12/22- 6" 3832
Viola
Top ~~Cilic~~ lime 3833
1200' oil in 12 hrs
from 3839-52
T.D. 3891 Bad hole
No increase
12/30- Drlg 3935'
No increase
1932
1/6- S.D. 3935'
1/13 T
1/20- Green shale 3980-4017
Cilic lime 4017
HFW 4034-39
S.D. 4052'
1/27- T.D. 4052
P.B. to 3872
shot 120 qt 3840-70
Cly out
2/3- Top Cilic lime 4017
1 1/2 bails water per
hour 4025-28
T.D. 4052
P.B. to 3872
shot 120 qt 3840-70
No results
Abandon

Map No. 83 ANSAS Sec. 11 Twp. 24 R. 12WWell No. 1 GrayRosenthal & Standline Company

Contractor

SECTION PLAT

1320 Ft. from N. Line

..... Ft. from S. Line

1320 Ft. from E. Line

..... Ft. from W. Line

FIRST REPORTS

Location ✓

Rig up

Drilling and Remarks:

RECORD

Cased in., ft.

Sand

Gas

Oil

Total Depth

PRODUCTION

1st 24 hrs. Nat.

1st 24 hrs. after shot

Gas Cu. Ft.

Dry Hole

Abandoned

Date

FEB 18 1931S. J. LEWIS Scout

83

KANSAS

Map No.

Sec.

11

Twp.

24

R. 13

W

Well No. 1

Resenthal Standline & American Company

Contractor

COMPLETED

SECTION PLAT

1320 Ft. from N. Line

Ft. from S. Line

1320 Ft. from E. Line

Ft. from W. Line

ABANDONED

Location

RECORD

Cased in., ft.

Sand

Gas

Oil

Total Depth 4052

PRODUCTION

1st 24 hrs. Nat.

1st 24 hrs. after shot

Gas Cu. Ft.

Dry Hole ☒Abandoned ☒

Drilling and Remarks:

Top Siliceous 4017
 1/2 BW 4025-28
 PB to 3872
 Shot 120/3840-70
 no results.

Date

FEB

3 1932

19

CHAS. L. SHERWOOD

Scout