


KANSAS

Stafford county

Section 11 Township 24 Range 13-W

Well No. #2, Gray

Company Alkay Oil

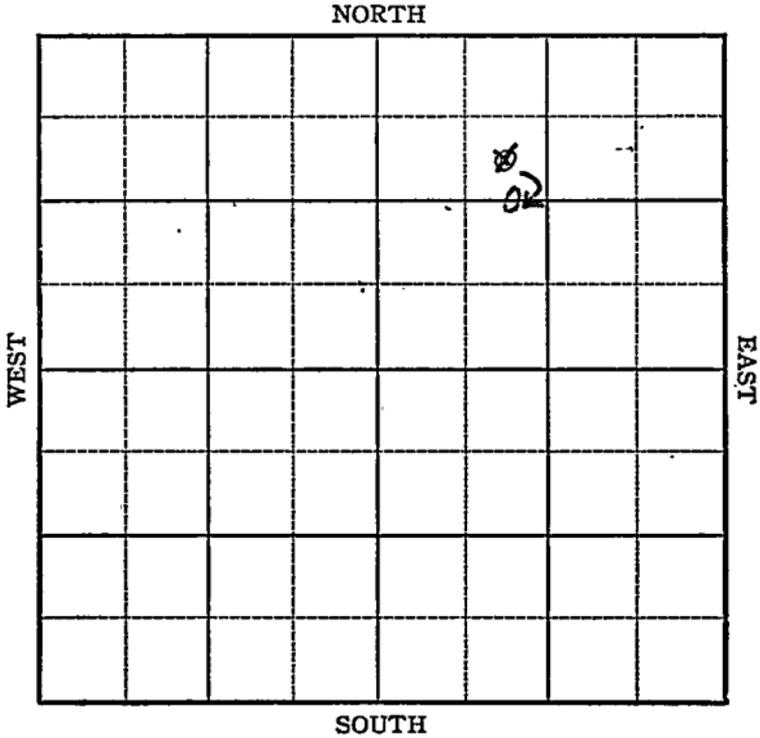

Sec. 11 Twp. 24 R. 13W

Well No. #2 Gray Farm _____
Alkay Oil Company _____


1300 Gray
~~990~~ Ft. from N. Line

_____ Ft. from S. Line

_____ Ft. from E. Line

1090
~~990~~ Ft. from W. Line

CELW 1/2 NE
~~SE NW NE~~

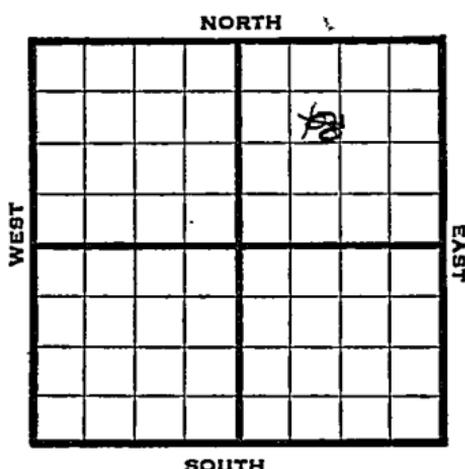

1946

Elev. 1916'

REPORT

10/9

Anhy 740'
 8" @ 750
 WOC R

10/15

Drlg 2010'

10/22

2 Drlg 3390'

10/29

Lans 3535'
 Viola 3854-76 TD
 5" @ 3856, RUST

11/6

" "

11/12

5" @ 3752' Corrected
 75' oil 17 hrs, CO

11/20

TD 3790'
 PB 3000 acid

11/27

" "

12/4

Viola 3854'
 5" @ 3752'
 TD 3877'
 3000 Acid
 Pump 385 Pot
 40 Grav.

COMPLETED

Map No. 83 Sec. 11 Twp. 24 R. 13W
 Kansas Gray

Well No. 2 Gray


Alkay Oil Company

FIRST REPORT Contractor

SE NW NE

SECTION PLAT

990 Ft. from N. Line
 _____ Ft. from S. Line
 _____ Ft. from E. Line
990 Ft. from W. Line

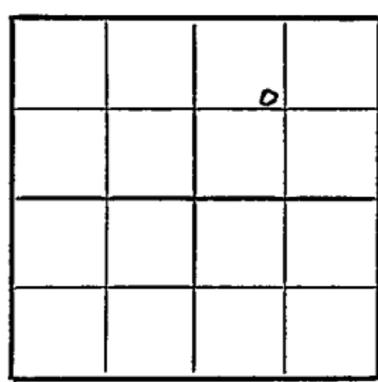

Stafford County

Location _____

Rig up _____

Drilling and Remarks:

Anhy 740'

8" @ 750' WOC

RECORD

Cased _____ in., _____ ft.
 Sand _____
 Gas _____
 Oil _____
 Total Depth _____

PRODUCTION

1st 24 hrs. Nat. _____
 1st 24 hrs. after shot _____
 Gas _____ Cu. Ft.
 Dry Hole _____
 Abandoned _____

Date

OCT 9 1946 19

S. J. LEWIS Scout

Map No. 83 Sec. 11 Twp. 24 R. 13W

Well No. 2 Gray

Alkay Oil Company

CORRECTION

Contractor

C E L W $\frac{1}{2}$ NE


SECTION PLAT

1300 Ft. from N. Line

_____ Ft. from S. Line

_____ Ft. from E. Line

1090 Ft. from W. Line

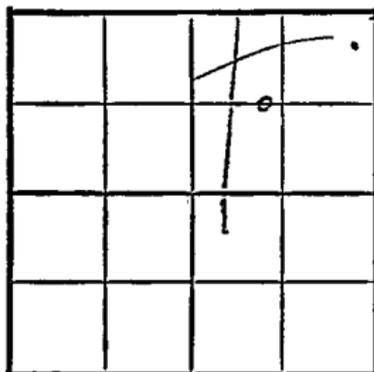

Stafford County

Location _____

Rig up _____

Drilling and Remarks:

Reported
SE NW NE

RECORD

Cased _____ in., _____ ft.

Sand _____

Gas _____

Oil _____

Total Depth _____

PRODUCTION

1st 24 hrs. Nat. _____

1st 24 hrs. after shot _____

Gas _____ Cu. Ft.

Dry Hole _____

Abandoned _____


Date

OCT 23 1946 19

S. J. LEWIS Scout

KANSAS
Kansas

Gray Pool

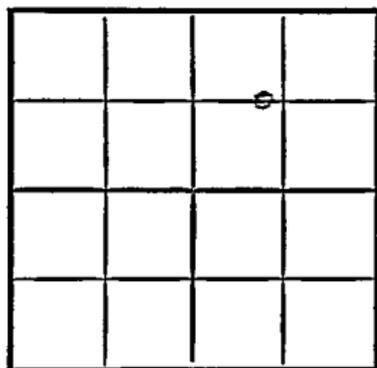Map No. 83 Sec. 11 Twp. 24 R. 13WWell No. 2 GrayAlkay Oil Company**COMPLETED** ContractorC E L $W\frac{1}{2}$ NEE 1, 1916
SECTION PLAT1300 Ft. from N. Line Ft. from S. Line Ft. from E. Line1090 Ft. from W. Line

Stafford County

Location _____

Rig up _____

Drilling and Remarks:

Via to 3854
5' @ 3752
3000 acid
Pump 3850

40 2/3

RECORD

Cased _____ in., _____ ft.

Sand _____

Gas _____

Oil _____

Total Depth 3877

PRODUCTION

1st 24 hrs. Nat. _____

1st 24 hrs. after shot _____

Gas _____ Cu. Ft.

Dry Hole _____

Abandoned _____

Date

DEC 4 1946 19

S. J. LEWIS Scout