


KANSAS Stafford county

Section 11 Township 24 Range 13W

Well No. #1, Gray

Company Coralena

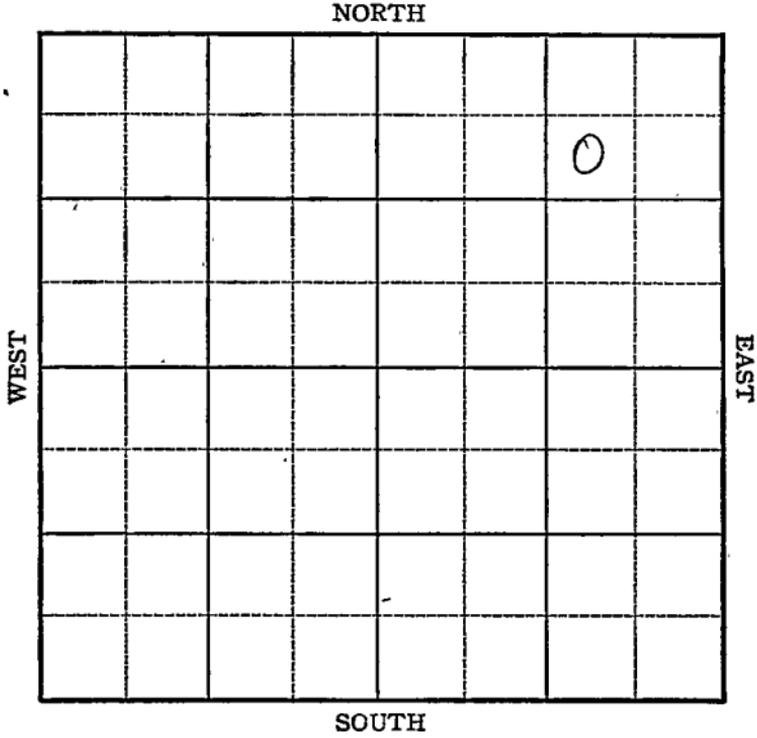

KANSAS

Stafford County ✓

Sec. 11 Twp. 24 R. 13W

Well No. #1 Gray Farm _____
Coralena Company _____

Wildcat


990 Ft. from N. Line

_____ Ft. from S. Line

990 Ft. from E. Line

_____ Ft. from W. Line

SW NE NE

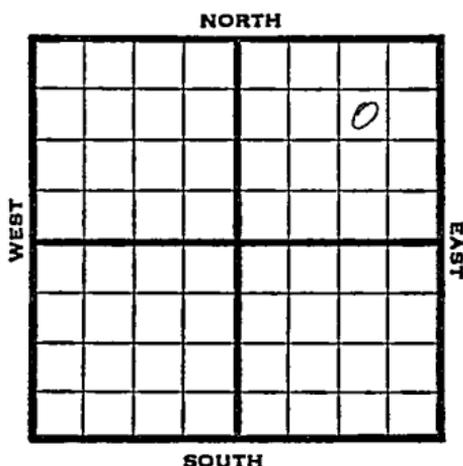

1946 Elev. 1901 REPORT

3/27 RUR
Twin to dry hole

4/4 Anhy. 733
8" @ 746
Drlg. 2153

4/10 Topeka 3020
Lans 3500
Drlg 3712

4/16 Viola 3842
TD 3882 PB 3762 5" @ 3743
275' oil 15 hrs.

4/23 1000 acid

5/1 Viola 3842
5" @ 3843
1000 acid.
TD 3882'
Pump 480 Pot.
Grav. 39.0

COMPLETED

KANSAS Kansas Pool Name Wildcat
 Map No. 83 Sec. 11 Twp. 24 R. 13W
 Well No. 1 Gray

Coralena

Company

FIRST REPORT

Contractor

SW NE NE


SECTION PLAT

990 Ft. from N. Line

_____ Ft. from S. Line

990 Ft. from E. Line

_____ Ft. from W. Line

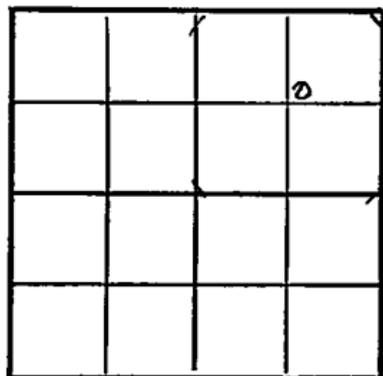

Stafford County

Location _____

Rig up _____

Drilling and Remarks:

R U R

Twin to dry
hole

RECORD

Cased _____ in., _____ ft.

Sand _____

Gas _____

Oil _____

Total Depth _____

PRODUCTION

1st 24 hrs. Nat. _____

1st 24 hrs. after shot _____

Gas _____ Cu. Ft.

Dry Hole _____

Abandoned _____

Date

MAR 27 1946 19

S. J. LEWIS Scout

KANSAS Pool Name St. Johns
 Map No. 23 Sec. 11 Twp. 24 R. 13W

Well No. 1 Gray

Coralena Company

COMPLETED

Contractor

SW NE NE

E, 1901
SECTION PLAT

990 Ft. from N. Line

 Ft. from S. Line

990 Ft. from E. Line

 Ft. from W. Line

			Δ

Stafford County

Location _____

Rig up _____

Drilling and Remarks:

Vista 3842
5" @ 3843
1000 acid
Pump 480 188

39° lb

RECORD

Cased _____ in., _____ ft.

Sand _____

Gas _____

Oil _____

Total Depth 3842

PRODUCTION

1st 24 hrs. Nat. _____

1st 24 hrs. after shot _____

Gas _____ Cu. Ft.

Dry Hole _____

Abandoned _____

Date

MAY 1 1946 19

S. J. LEWIS

Scout