

Stafford

FORM 51 25M 3-49 PETROL

KANSAS

Section 11 Township 24 Range 14W

Well No. #1 Davis

Company Sunray

NORTH

10							

WEST

EAST

SOUTH

Sec. 11 Twp. 24 R. 14 W

Well No. # 1 Davis Farm

Sunray Company

Ryan Contractor

Rattlesnake Pool


_____ Ft. from N. Line

330 Ft. from S. Line

_____ Ft. from E. Line

330 Ft. from W. Line

SW SW NW

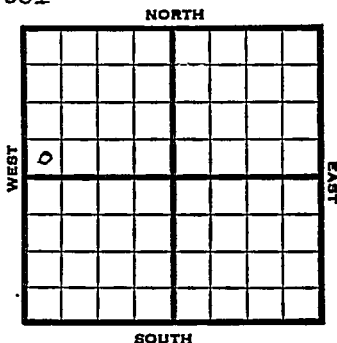

1951 *Elev. 1954* REPORT

10/3
11/28

RUR
 Spud 10-5-51
 Oil Well TD 4026
 8" @ 443
 Br Line 3618 Lans. 3645
 DST 3763¹/₂77 opn 1 hr.
 Rec. 148' mud & oil
 DST 3808-17 opn 1 hr
 Rec. 62' wtr
 Marm. 3918 Cong. 4004
 Viola 4022 TD 4026
 5" @ 4024
 GO to 3933
 16/3768-72 1600 A
 S/5 boph P/25 bo 15 bwpd 3 days
 Comp. 20 bopd 5% wtr.

COMPLETED

County **Stafford** State **Kansas**

Sec. **11** (Blk.) **24** (Sur. Rge.) **14W** Map No.

Operator **Sunray**

Well No. **1** Farm **Davis**

Elev. **1954** Location **SW SW NW**

330 Ft. From S Line NW

330 Ft. From W Line Quarter

Ist. Report

Completion **NOV 28 1951**

Remarks **Rattlesnake Pool**

Rine Drlg. - Contr.

Spudding Date **10-5-51**

Drlg. Data **Oil well TD 4026**

8" @ 443 Br. line 3618 Lans. 3645

DST 3763-77 open 1 hr. Rec. 148' mud

& oil DST 3808-17 open 1 hr. Rec. 62'

water Marm. 3918 Cong. 4004 Viola 4022

TD 4026 5" @ 4024 CO to 3933 16/ 3768-72

1600 A S/ 5 boph P/ 25 bo 15 bwpd 3 days

Comp. 20 bopd 5% water

J. E. TYRA