

Sec. 11 Twp. 24 R. 14W

Well No. #2 Kolesch "B" "P" Farm

Lindas Oil Company

Contractor


990' Ft. from N. Line

Ft. from S. Line

Ft. from E. Line

330' Ft. from W. Line

SW NW SW

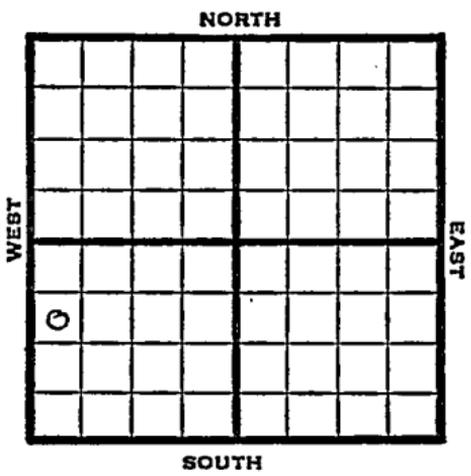

1950

Elev 1951

REPORT

6/14
7/19

Rig up
 8" @ 221
 Anhy 866
 Lans 3636
 5" @ 4042
 36/3763-69
 1500 acid
 F/25 boph
 F/15 boph
 F/6 boph
 Comp 235 bopd
 TD 4050
 Completed

Heeh 3481
 Viola 4026-50

COMPLETED

Kansas

Map No. _____ Sec. 11 Twp. 24 R. 14WWell No. 1 Kolesch "D"_____ Lindas Oil _____ Company

_____ Contractor

SW NW SW

SECTION PLAT

990 Ft. from N. Line

_____ Ft. from S. Line

_____ Ft. from E. Line

330 Ft. from W. Line

o			

FIRST REPORT

Stafford County

Location _____

Rig up X

Drilling and Remarks:

British-American
farmout

RECORD

Cased _____ in., _____ ft.

Sand _____

Gas _____

Oil _____

Total Depth _____

PRODUCTION

1st 24 hrs. Nat. _____

1st 24 hrs. after shot _____

Gas _____ Cu. Ft.

Dry Hole _____

Abandoned _____

Date

JUN 14 1950J. E. TYRA Scout

Map No. _____ Sec. 11 Twp. 24 R. 14WWell No. 2 Koelsch "B"_____ Lindas Oil _____ Company_____ CORRECTION _____ Contractor

SW NW SW

SECTION PLAT

990 Ft. from N. Line

_____ Ft. from S. Line

_____ Ft. from E. Line

330 Ft. from W. Line

Stafford County

Location _____

Rig up _____

Drilling and Remarks:

Completed7-19-50#1 Koelsch "D"

RECORD

Cased _____ in., _____ ft.

Sand _____

Gas _____

Oil _____

Total Depth _____

PRODUCTION

1st 24 hrs. Nat. _____

1st 24 hrs. after shot _____

Gas _____ Cu. Ft.

Dry Hole _____

Abandoned _____

Date

APR 11 195119J. E. TYRAScout

Kansas

Map No. _____ Sec. 11 Twp. 24 R. 14W

Well No. 1 Kolesch "D"

Lindas Oil

Company

Contractor

SW NW SW


E1, 1951
SECTION PLAT

990 Ft. from N. Line

_____ Ft. from S. Line

_____ Ft. from E. Line

330 Ft. from W. Line

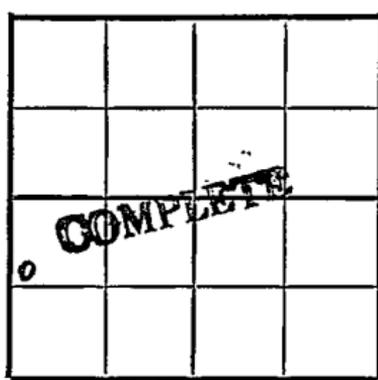

Stafford County

Location _____

Rig up _____

Drilling and Remarks:

8" @ 221

Anhy 866

Heeb. 3481

Lans. 3636

Viola 4026-50

5" @ 4042

36/ 3763-69

RECORD

Cased _____ in., _____ ft.

Sand _____

Gas _____

Oil _____

Total Depth 4050

PRODUCTION

1st 24 hrs. Nat. _____

1st 24 hrs. after shot _____

Gas _____ Cu. Ft.

Dry Hole _____

Abandoned _____

Date

19 1950

19

J. E. TYRA Scout


1500 acid

F/ 25 boph

F/ 15 boph

F/ 6 boph

Comp. 235 bopd

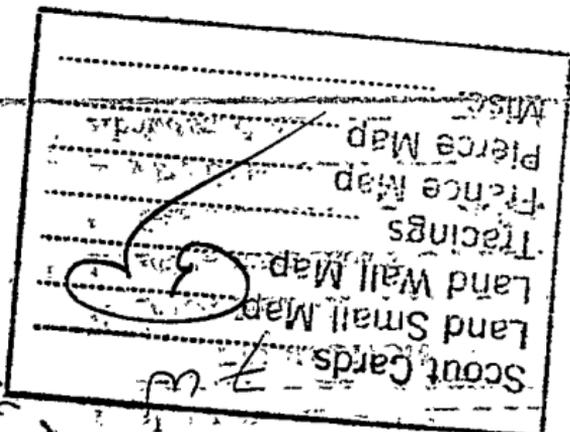

RECEIVED