


Section 11 Township 24 Range 14W

Well No. #3 Koelsh "B"

Company Lindas Oil

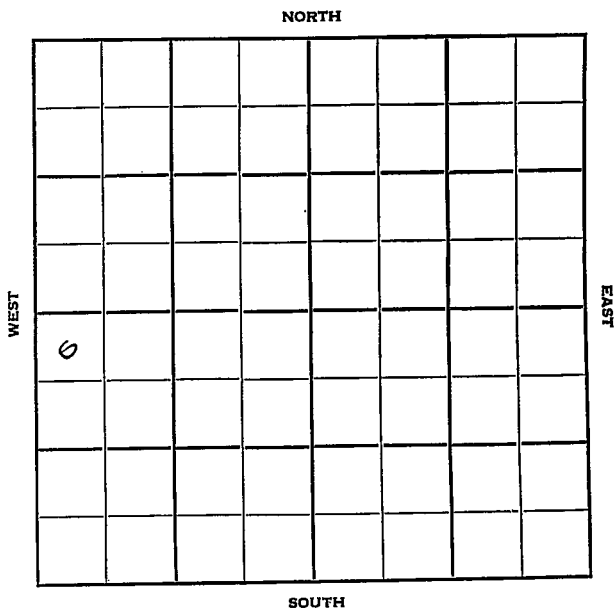

Stafford

KANSAS

Sec. 11 Twp. 24 R. 14 W

Well No. # 3 Koelsh "B" Farm \_\_\_\_\_

Lindas Oil Company \_\_\_\_\_

Contractor \_\_\_\_\_


330 Ft. from N. Line

\_\_\_\_\_ Ft. from S. Line

\_\_\_\_\_ Ft. from E. Line

330 Ft. from W. Line

NW NW SW

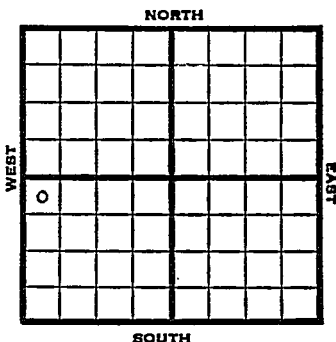

1951

Elev. 1953'

REPORT

4/11

Location

6/20

Spud 4-7-51

Oil well TD 4050' 8" @ 426

Anhy 870' Lans. 3638'

DST 3759-72 open  $\frac{1}{2}$  hr. rec 165' mud & oil. Cong. 4000' Viola 4016'

DST 4020-50 open 45 min. rec 63' OCM

TD 4050' 5" @ 4049 16/4043-47

24/4032-40 36/4616-34 500 A

14/4001-07 SP 3815' 24/3765-71

S/8 GOPH 1500 A S/10 BOPH

Comp. 203 BOPD

**COMPLETED**



