

**KANSAS**

Stafford

Section 11 Township 24 Range 14WWell No. 1 PorterCompany Ben BrackWildcat  
NORTH.

|  |  |  |  |   |  |  |  |
|--|--|--|--|---|--|--|--|
|  |  |  |  |   |  |  |  |
|  |  |  |  |   |  |  |  |
|  |  |  |  |   |  |  |  |
|  |  |  |  | 0 |  |  |  |
|  |  |  |  |   |  |  |  |
|  |  |  |  |   |  |  |  |
|  |  |  |  |   |  |  |  |
|  |  |  |  |   |  |  |  |

WEST

EAST

SOUTH

KANSAS

Stafford

Sec. 11 Twp. 24 R. 14W ✓Well No. #1 Porter FarmBen Brack Company

Wildcat (Brack, Cont.)

Ft. from N. Line

330'

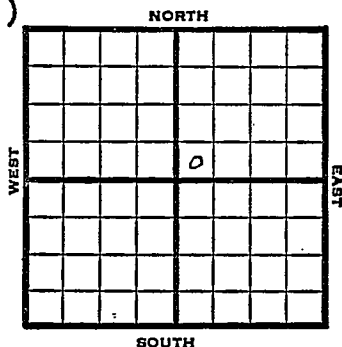
Ft. from S. Line

Ft. from E. Line

330'

Ft. from W. Line

SW NE



1949

Elev. 1956' REPORT

6/1 Surface Hole

6/7 8" @ 217'  
Drlg 3200'4160  
1956  
-22046/15 Lansing 3651'  
Miss 4018'  
Drlg. 4044'6/22 Viola 4102'  
Simp. 4160'  
Arb. 4207'  
TD 4232'

ABANDONED

Kansas

Map No. \_\_\_\_\_ Sec. 11 Twp. 24 R. 14WWell No. 1 Porter

\_\_\_\_\_ Ben Brack \_\_\_\_\_ Company

\_\_\_\_\_ Brack \_\_\_\_\_ Contractor

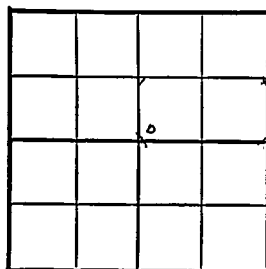
SW NE

FIRST REPORT  
SECTION PLAT

\_\_\_\_\_ Ft. from N. Line

330 Ft. from S. Line

\_\_\_\_\_ Ft. from E. Line

330 Ft. from W. Line

Stafford County

Location \_\_\_\_\_

Rig up \_\_\_\_\_

Drilling and Remarks:

surface hole

## RECORD

Cased \_\_\_\_\_ in., \_\_\_\_\_ ft.

Sand \_\_\_\_\_

Gas \_\_\_\_\_

Oil \_\_\_\_\_

Total Depth \_\_\_\_\_

## PRODUCTION

1st 24 hrs. Nat. \_\_\_\_\_

1st 24 hrs. after shot \_\_\_\_\_

Gas \_\_\_\_\_ Cu. Ft.

Dry Hole \_\_\_\_\_

Abandoned \_\_\_\_\_

Date

JUN 1 1949 19 \_\_\_\_\_ S. J. LEWIS \_\_\_\_\_ Scout

Kansas

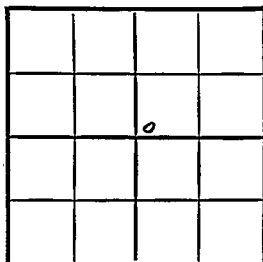
Map No. 483 Sec. 11 Twp. 24 R. 14WWell No. 1 PorterBen Brack

Company

**ABANDONED**

Contractor

SW NE

21.1956  
SECTION PLAT

Ft. from N. Line

330

Ft. from S. Line

Ft. from E. Line

330

Ft. from W. Line

Stafford County

## RECORD

Location

Cased \_\_\_\_\_ in., \_\_\_\_\_ ft.

Rig up

Sand \_\_\_\_\_

Drilling and Remarks:

Gas \_\_\_\_\_

Oil \_\_\_\_\_

Total Depth 4232

## PRODUCTION

1st 24 hrs. Nat. \_\_\_\_\_

1st 24 hrs. after shot \_\_\_\_\_

Gas \_\_\_\_\_ Cu. Ft.

Dry Hole \_\_\_\_\_

Abandoned \_\_\_\_\_

Date

JUN 22 1949

19

S. J. LEWIS

Scout