


Section 11 Township 24 Range 15W

Well No. 1 Hardten

Company Seaney & Ellet

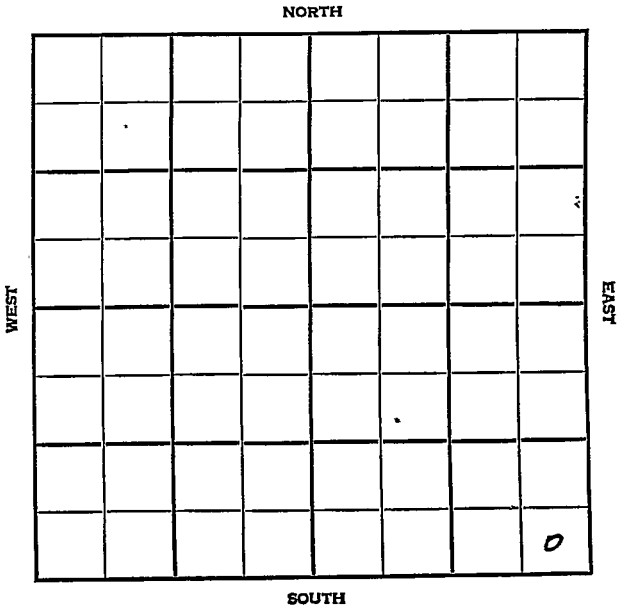

Stafford

KANSAS

SEC.	TWP.	R.
11	24	15 W


WELL NO. # 1 Hardten FARM

COMPANY Seaney & Ellet & Jones, Shelburne & Farmer

CONTRACTOR J. S. Greenland Drlg.

E. Maxville Pool

_____ Ft. from N. Line
 330 _____ Ft. from S. Line
 330 _____ Ft. from E. Line
 _____ Ft. from W. Line

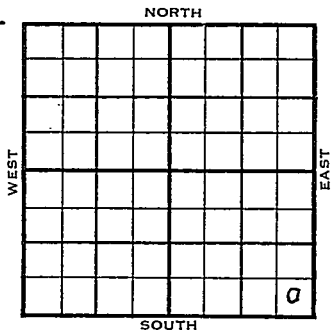

SE SE SE

	ELEVATION	REPORT
1954	2004'	

5/26
6/2
6/9

Location
 "
 8" @ 215'
 Anhy 956'
 Drlg. 2198'

6/23

Spud 6-4-54 D & A TD 4188
 8" @ 215' Anhy 956' Heeb 3508
 Tor. 3528' Br. lime 3647 Lans 3657
 Cong. 4013 Viola 4027
 DST 4047-83 open 1/2 hr rec 70' mud
 400# Arb. 4146
 TD 4188' D & A

ABANDONED

