


DX 78-1

Section 11 Township 24 Range 16W

Well No. #1 Klein

Company H.G. Kaiser

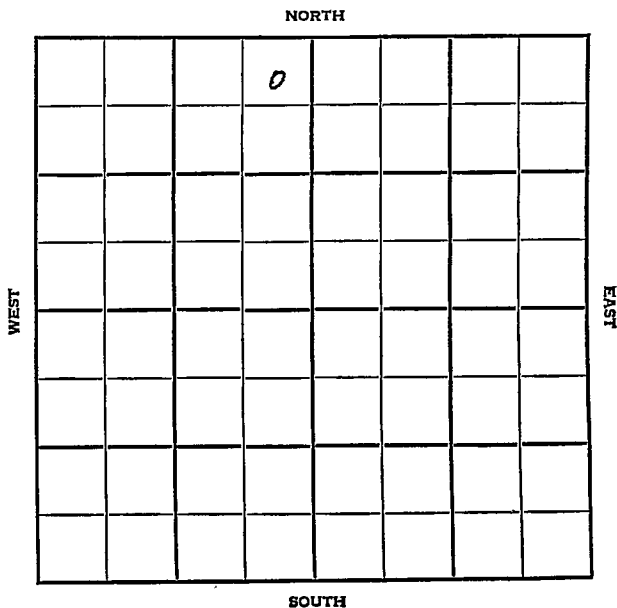

Edwards KANSAS


SEC.	TWP.	R.
11	24	16W

WELL NO. 1 Klein FARM

COMPANY H. G. Kaiser

CONTRACTOR Armer Tools

330 Ft. from N. Line
 _____ Ft. from S. Line
 330 Ft. from E. Line
 _____ Ft. from W. Line

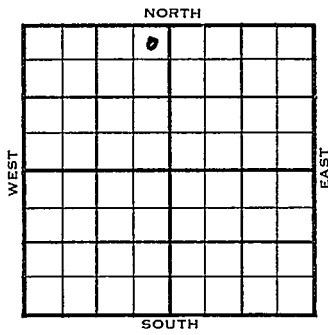

NE NE NW

	ELEVATION	REPORT
1954	2059'	

9/15 Drlg.
 929 Spud 9-15-54 - D&A
 TD 4130'
 8-5/8" @ 202'
 Anhy 1005', Lans 3668'
 DST 3690-3706', opn 1 hr., rec. 90'
 SO&GCM, 0#
 DST 3795-3811', opn 1 hr., rec. 40'
 SO&GCM, 155#
 Marm. 3903', Viola 4047'
 DST 4049-98', opn 1 hr., rec. 30' mud
 550#
 Simpl. 4073', Arb. 4111'
 DST 4113-30', opn 20", gas in 1", sul
 wtr in 13", 5,000,000 cfcpd, 1360#
 TD 4130'
 D&A

ABANDONED

County Edwards State KansasSec. 11 (Blk. Twp.) 24 (Sur. Rge.) 16W Map No.Operator H. G. KaiserWell No. 1 Farm KleinElev. Location NE NE NW

530 Ft. From N Line NW330 Ft. From E Line Quarter1st. Report SEP 15 1954

Completion

Remarks

Armer Tools


Spudding Date

Drig. Data

Drig.

FABEN GILSTRAP

County Edwards State Kansas
 Sec. 11 (Blk. 24) (Sur. 16W) (Twp. Map No.)
 Operator H. G. Kaiser
 Well No. 1 Farm Klein
 Elev. 2059 Location NE NE NW

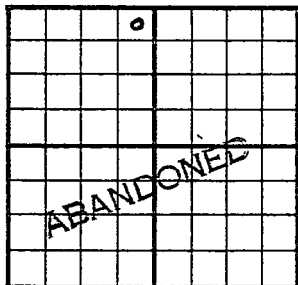

330 Ft. From N Line NW
330 Ft. From E Line Quarter
 Ist. Report Sep 15 1954
 Completion SEP 29 1954
 Remarks Armer Tools

Spudding Date 9-15-54

Drlg. Data D & A TD 4130

8 5/8" @ 202 Anhy 1005 Lans. 3668
DST 3690-3706 open 1 hr. Rec. 90' so
& gcm 0# DST 3795-3811 open 1 hr.
Rec. 40' so & gcm 155# Marm. 3903
Viola 4047 DST 4049-98 open 1 hr.
Rec. 30' mud 550# Simp. 4073
Arb. 4111 DST 4113-30 open 20 min.
gas in 1 min. sul. wtr. in 13 min.
5,000,000 cfcpd 1360# TD 4130

D & A

FABEN GILSTRAP