


Section 11 Township 24 Range 34W

Well No. #1 Kansas

Company Champlin Ref.

Hugoton Pool

NORTH

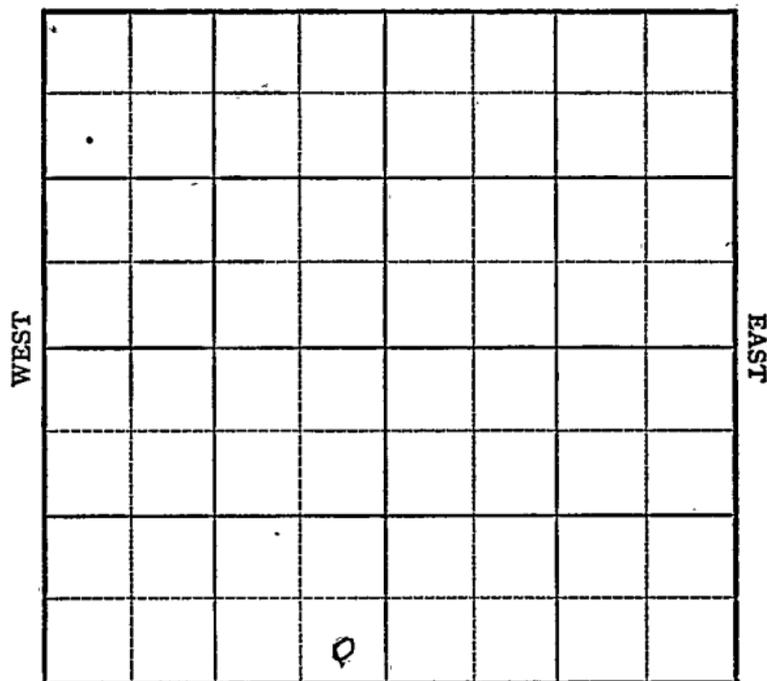

SOUTH



Sec. 11 Twp. 24 R. 34W

Well No. #1 Kansas Farm _____

Champlin Ref. Company _____

Moran Drlg. Contractor _____


Hugoton Pool
_____ Ft. from N. Line

330' Ft. from S. Line

330' Ft. from E. Line

330' Ft. from W. Line

SW NE
~~SE SW~~

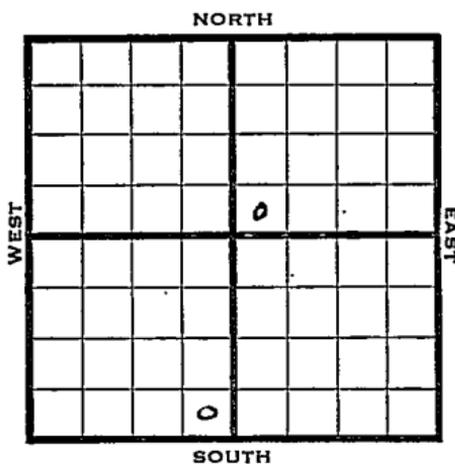

1949

Elev. 2892' REPORT

11/2 Location
11/9 10" @ 804'
11/16 TD 2686'
7" @ 2576'
11/23 "
11/29 "
12/7 204 shots 2548-78
3000 acid
12/14 366 shots 2422-2500
10,500 acid
12/21 "
12/28 "
3/1 10" @ 804'
7" @ 2576'
Hev 2421'
Win 2482'
1,324,000 CFGPD
TD 2586'

COMPLETED

Sec. 11 Twp. 24 R. 34-W

Well No. #1 Kansas Farm

Champlin Ref. Company

Contractor


Ft. from N. Line

330 Ft. from S. Line

Ft. from E. Line

330 Ft. from W. Line

SW SW NE

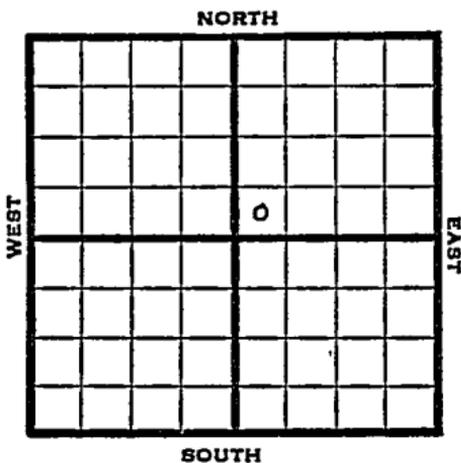

1950

Elev 2892

REPORT

3/1

10" @ 804
 7" @ 2576
 TD 2586
 Hev ~~2421~~
 Win 2482
 Towanda 2534
 500A
 204/2548-78 3000A
 96/2484-2500 2000A
 180/2441-59
 90/2422-37 8500A
 36/2390-96 14,000A
 Comp 1,324 gas
 Completed

COMPLETED

Kansas

Map No. _____ Sec. 11 Twp. 24 R. 34WWell No. 1 Kansas

Champlin Ref. _____ Company

Moran Drlg. _____ Contractor

FIRST REPORT
SECTION PLAT

SE SW

_____ Ft. from N. Line

330 Ft. from S. Line330 Ft. from E. Line

_____ Ft. from W. Line

Finney County

Location X

Rig up _____

Drilling and Remarks: _____

RECORD

Cased _____ in., _____ ft.

Sand _____

Gas _____

Oil _____

Total Depth _____

PRODUCTION

1st 24 hrs. Nat. _____

1st 24 hrs. after shot _____

Gas _____ Cu. Ft.

Dry Hole _____

Abandoned _____

Date

NOV 2 1949 19

S. J. LEWIS Scout

Map No. _____ Sec. 11 Twp. 24 R. 34W

Well No. 1 Kansas

_____ Champlin Ref. _____ Company

_____ Contractor

SW NE

SECTION PLAT

_____ Ft. from N. Line

330 Ft. from S. Line

_____ Ft. from E. Line

330 Ft. from W. Line

Finney County

Location _____

Rig up _____

Drilling and Remarks:

Reported

SE SW

RECORD

Cased _____ in., _____ ft.

Sand _____

Gas _____

Oil _____

Total Depth _____

PRODUCTION

1st 24 hrs. Nat. _____

1st 24 hrs. after shot _____

Gas _____ Cu. Ft.

Dry Hole _____

Abandoned _____

Date

NOV 9 1949 19

S. J. LEWIS

Scout

Kansas

Map No. _____ Sec. 11 Twp. 24 R. 34 WWell No. 1 Kansas

Champlin Ref.

Company

Contractor

SW NE

El. 2892
SECTION PLAT

_____ Ft. from N. Line

330 Ft. from S. Line

_____ Ft. from E. Line

330 Ft. from W. Line

COMPLETE			
		o	

Finney County

Location _____

Rig up _____

Drilling and Remarks:

10" @ 8047" @ 2576br 2421win 24821,324,000C.F.G.P.D

RECORD

Cased _____ in., _____ ft.

Sand _____

Gas _____

Oil _____

Total Depth 2586

PRODUCTION

1st 24 hrs. Nat. _____

1st 24 hrs. after shot _____

Gas _____ Cu. Ft.

Dry Hole _____

Abandoned _____

Date

MAR 1 1950

19

J. E. TYRA Scout

Map No. _____ Sec. 11 Twp. 24 R. 34W

Well No. 1 Kansas

Champlin Ref. Company

Contractor

SW SW NE


El. 2892
SECTION PLAT

_____ Ft. from N. Line

330 Ft. from S. Line

_____ Ft. from E. Line

330 Ft. from W. Line

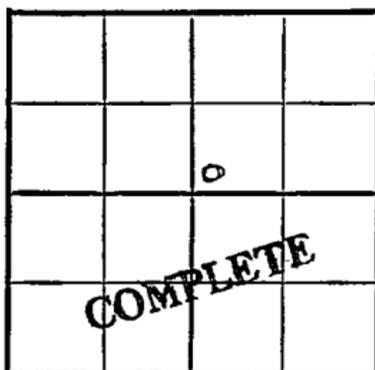

Finney

Location _____

Rig up _____

Drilling and Remarks:

10" C 804
7" C 2576
Dev. 2421
Win. 2482
Towards 2534
500 A

RECORD

Cased _____ in., _____ ft.

Sand _____

Gas _____

Oil _____

Total Depth 2586

PRODUCTION

1st 24 hrs. Nat. _____

1st 24 hrs. after shot _____

Gas _____ Cu. Ft.

Dry Hole _____

Abandoned _____


Date

Mar. 1 1950 J. E. TYRA Scout

204/ 2548-78 2000 A
 96/ 2484-2500 2000 A
 180/ 2441-57
 90/ 2422-37
 36/ 2390 96
 Camp. 1, 3 24

Misc.	2000 A
Pierce Map	2000 A
France Map	
Tracings	2000 A
Land Wall Map	
Land Small Map	
Scout Cards	2000 A

1956
 1957
 1958
 1959
 1960

 

1961
 1962
 1963
 1964
 1965
 1966
 1967
 1968
 1969
 1970