


Section 11 Township 24 Range 35-W

Well No. #1 Garden City "O"

Company Cities Service

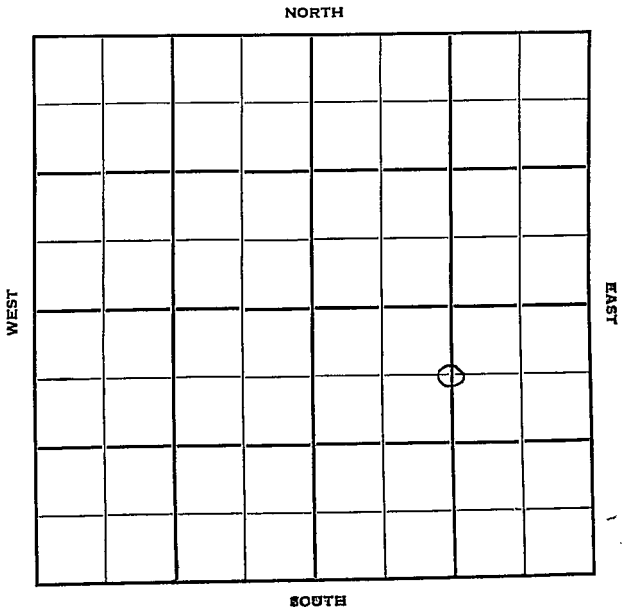

Sec. 11 Twp. 24 R. 35W

Well No. #1 Garden City "O" Farm

Cities Service Company

Hugoton Pool Contractor


660' Ft. from N. Line

_____ Ft. from S. Line

1320' Ft. from E. Line

_____ Ft. from W. Line

C N L SE

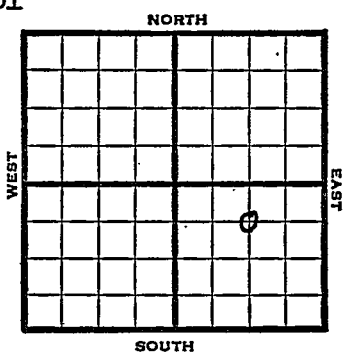

1950 Elev 2943 REPORT

8/23 Spud 8-19-50
8" @ 600'
WOC

10/11 8" @ 600
5" @ 2639
TD 2640
Her 2418 Krider 2448
Win 2514 Ft. Riley 2570
30/2590-96
60/2572-84, 60/2516-28, 80/2474-90
90/2450-68
25600 total acid
Comp 8,770,000 gas
Completed

COMPLETED

County Kearny State Kansas

Sec. 11 (Blk.) 24 (Sur.) 35W Map No.

Operator Cities Service

Well No. 1 Farm Garden City "0"

Elev. Location C N L SE

660 Ft. From N Line SE

1320 Ft. From E Line Quarter

1st. Report AUG 23 1950

Completion _____

Remarks _____

Spudding Date 8-19-50

Drlg. Data Hugoton Pool

8" @ 600 WOC

J. E. TYRA

County Kearny State Kansas

Sec. 11 (Blk. 24) (Sur. 35W) Map No.

Operator Cities Service

Well No. 1 Farm Garden City "0"

Elev. 2943 Location C N L SE

660 Ft. From N Line SE

1320 Ft. From E Line Quarter

1st. Report

Completion OCT 11 1950

Remarks Hugoton Pool

Spudding Date 8-19-50

Drlg. Data Gas well TD 2640

8" @ 600 5" @ 2639 TD 2640

Her. 2418 Krider 2448 Win. 2514

Ft. Riley 2570 30/ 2590-96 60/ 2572-84

60/ 2516-28 80/ 2474-90 90/ 2450-68

25500 total acid Comp. 8,770,000 gas

J. E. TYRA