


KANSAS

Harvey county

Section 12 Township 24 Range 3-W

Well No. #1, Brandenger

Company Starolind O&G Company

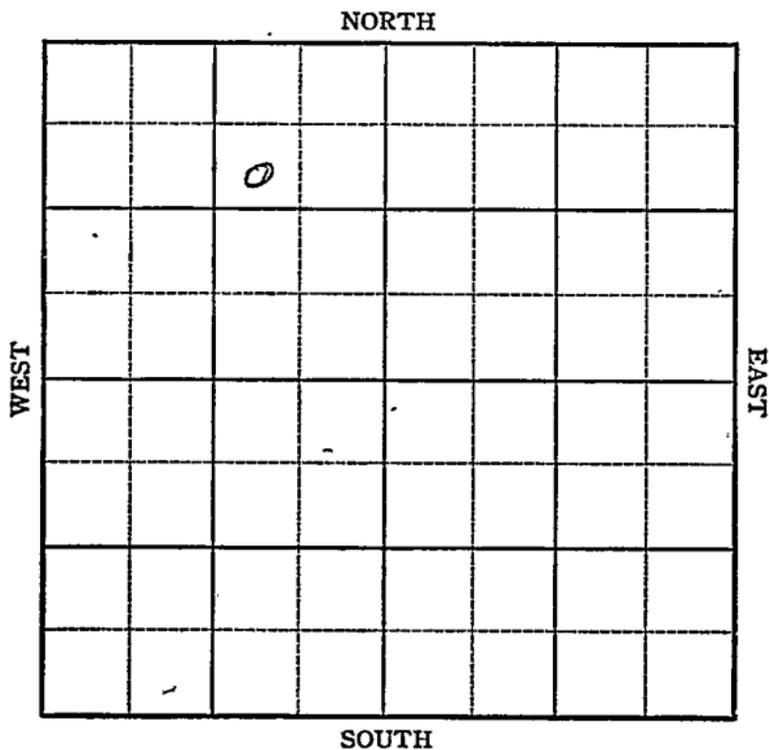

KANSAS

Harvey

Sec. 12 Twp. 24 R. 3W

Well No. #1 Brandenger Farm

Stanolind Company


Wildcat

990 Ft. from N. Line

Ft. from S. Line

990 Ft. from E. Line

Ft. from W. Line

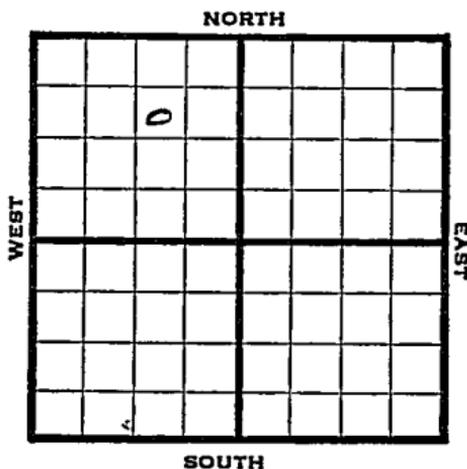

SW NE NW

REPORT

1946 Elev. 1427'

- 11/6 Location
- 11/12 RUR
- 11/20 13" @ 275'
Drlg 850'
- 11/27 8" @ 864'
Drlg 2545'
- 12/3 Lans 2538'
Miss 3364'
Drlg 3680'
- 12/10 Misner 3786'
Viola 3873'
Simp sd 3898'
Arb 3984'
TD 4018' SD
- 12/17 5" @ 3997'
32 shots 3876-84 SW & oil
- 1947
- 1/4 PB 3891'
16 shots 3875-79
500 acid
- 1/8 " "
- 1/15 Squeeze

OVER

1947

1/22 Simp Sd 3898'
Arb 3984'
5" @ 3997'
TD 4018'
PB 3880'
30 shots to 3875-3878'
Viola 3873'
1000 Acid
Pump 25 oil plus 25 W Pot
TD 4018'
26 Grav.

COMPLETED

Map No. 30 Sec. 12 Twp. 24 R. 3W

Well No. 1 Brandenger

Stanolind

Company

FIRST REPORT

Contractor

SW NE NW


SECTION PLAT

990 Ft. from N. Line

_____ Ft. from S. Line

990 Ft. from E. Line

_____ Ft. from W. Line

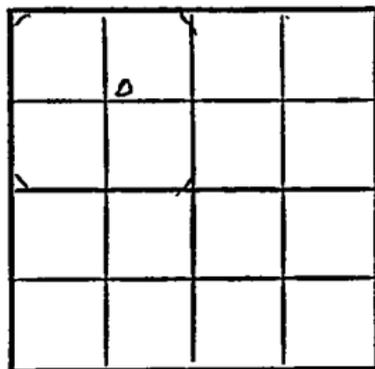

Harvey County

Location X

Rig up _____

Drilling and Remarks:

RECORD

Cased _____ in., _____ ft.

Sand _____

Gas _____

Oil _____

Total Depth _____

PRODUCTION

1st 24 hrs. Nat. _____

1st 24 hrs. after shot _____

Gas _____ Cu. Ft.

Dry Hole _____

Abandoned _____

Date

NOV 6 1946 19 _____

S. J. LEWIS Scout

