


Section 12 Township 24 Range 10W

Well No. 1 Miller

Company Schermerhorn Oil

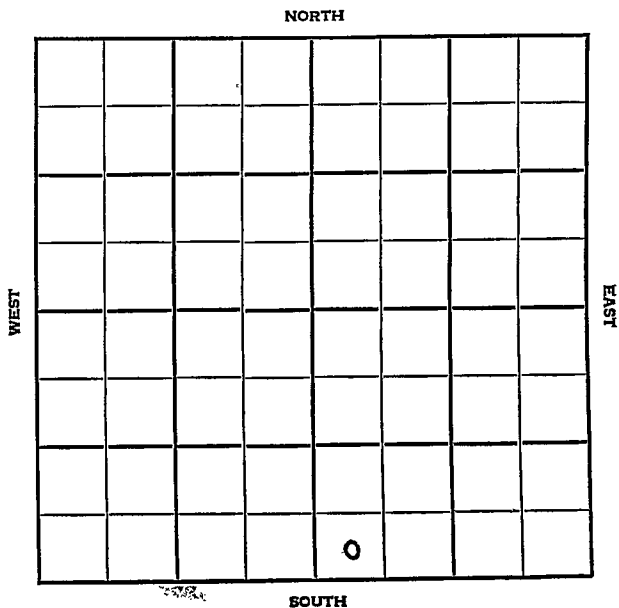

Reno KANSAS

SEC.	TWP.	R.
12	24	10W

WELL NO. _____
 COMPANY 1 Miller FARM

CONTRACTOR Schermerhorn Oil


Badger
Wildcat

_____ Ft. from N. Line

330 _____ Ft. from S. Line

_____ Ft. from E. Line

330 _____ Ft. from W. Line

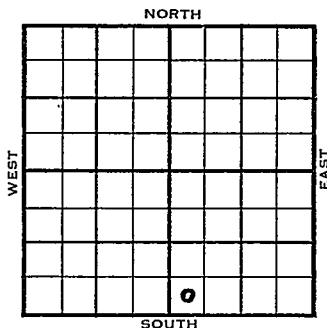

SW SW SE

1955	ELEVATION	REPORT
	1710' - 1707'	

2/9

Spud 1-25-55
 8" @ 238'
 Heeb. 3128', Br. lime 3305', ^Lans. 3326'
 DST 3375-3418', opn 1 hr., rec. 30' mud, O#
 Miss. 3757'
 DST 3774-90', opn 1 hr., rec. 220' muddy wtr, 1708#
 Viola 3984', Simp. 4072'
 Drlg. 4150'

2/16

Spud 1-25-55 - D&A
 TD 4180'
 8" @ 238'
 Heeb. 3128', Br lime 3305', ^Lans. 3326'
 DST 3375-3418', opn 1 hr., rec. 30' mud, O#
 Miss. 3757'
 DST 3774-90', opn 1 hr., rec. 220' muddy wtr, 1708#
 Viola 3984', Simp. 4072', Arb. 4156', TD 4180'
 Log Tops: Heeb. 3126', Br lime 3303, Lans. 3326', Miss 3779', Kh. 3826', Viola 3882', Simp. 4080', Arb. 4156'
 TD 4180' - D&A

ABANDONED

