


Stafford KANSAS

Section 12 Township 24 Range 11-W

Well No. #2 Emma McComb

Company Stanolind

NORTH Zenith Pool

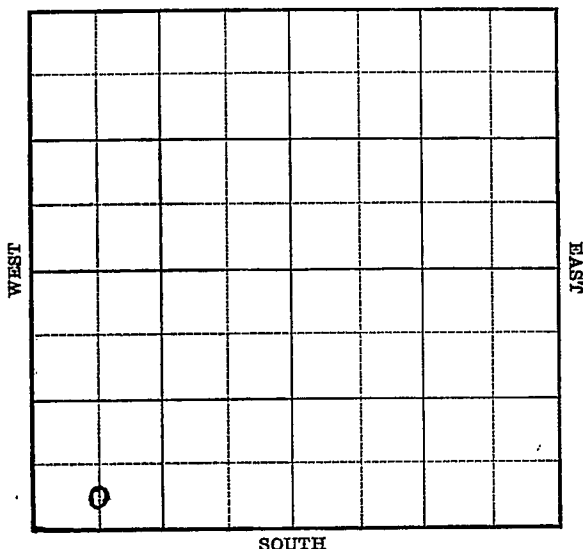

Stafford **KANSAS**Map No. 47 Sec. 12 Twp. 24 R. 11WWell No. 2 Emma McCombStanolind

Company

Contractor

FIRST REPORT**SECTION PLAT****C S L SW SW** Ft. from N. Line330 Ft. from S. Line Ft. from E. Line660 Ft. from W. Line

0			

ZENITH POOLLocation XRig up Drilling and Remarks: **RECORD**Cased in., ft.Sand Gas Oil Total Depth **PRODUCTION**1st 24 hrs. Nat. 1st 24 hrs. after shot Gas Cu. Ft.Dry Hole Abandoned

Date

MAY 31 1939 19

S. J. LEWIS

Scout

Map No. 47 Sec. 12 Twp. 24 R. 11WWell No. 2 Emma McCombStanolind

Company

Contractor

COMPLETED

C S L SW SW

Ft. from N. Line

330

Ft. from S. Line

Ft. from E. Line

660

Ft. from W. Line

ZENITH POOL

SECTION PLAT

Location

RECORD

Cased _____ in., _____ ft.

Sand _____

Gas _____

Oil _____

Total Depth 3761

PRODUCTION

1st 24 hrs. Nat. _____

1st 24 hrs. after shot _____

Gas _____ Cu. Ft.

Dry Hole _____

Abandoned _____

Rig up

Drilling and Remarks:

*Never 3739**6" @ 3739**Vista 3760**2000 aad**Bottom Hole pressure**lost 446*

Date

JUL 5 1939

19

S. J. LEWIS

Scout