

# KANSAS

Form 51-5M-7-40-Palace


Stafford

Section 12 Township 24 Range 11-W

Well No. #7 Stewart

Company E. H. Moore

NORTH Zenith Pool

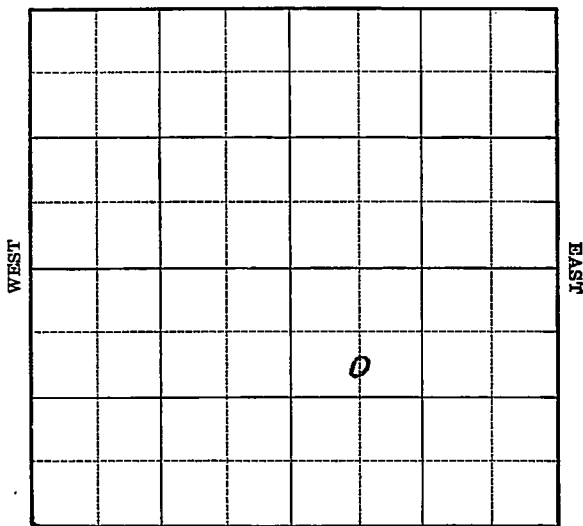

SOUTH

Sec. 12 Twp. 24 R. 11-W

Well No. #7 Stewart Farm

E. H. Moore Company

(Zenith)


99 0 Ft. from N. Line

\_\_\_\_\_ Ft. from S. Line

\_\_\_\_\_ Ft. from E. Line

66 0 Ft. from W. Line

Elev. 1791

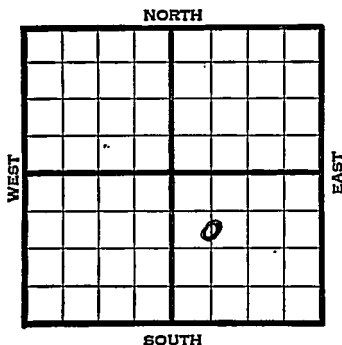

1940	REPORT
12/18	Derrick.
12/26	10" - 280' Drlg. 1760'
1941	
1/2	Drlg. 3095'
1/9	Core 3717-30' T.D. SSO Misener 3717' 5" - 3718' RUST.
1/15	Viola 3730' 5" - 3718' T.D. 3733' Bomb potential 5495 bbls. Maximum 3000 bbls. 42. Gravity
	COMPLETED

Map No. 47 Sec. 12 Twp. 24 R. 11W

Well No. 7 Stewart

E. H. Moore

Company

Contractor

**FIRST REPORT**

C S L NW SE

990 Ft. from N. Line

\_\_\_\_\_ Ft. from S. Line

\_\_\_\_\_ Ft. from E. Line

660 Ft. from W. Line

ZENITH POOL

**SECTION PLAT**

		o	

Location \_\_\_\_\_

Rig up \_\_\_\_\_

Drilling and Remarks:

Derrick

**RECORD**

Cased \_\_\_\_\_ in., \_\_\_\_\_ ft.

Sand \_\_\_\_\_

Gas \_\_\_\_\_

Oil \_\_\_\_\_

Total Depth \_\_\_\_\_

**PRODUCTION**

1st 24 hrs. Nat. \_\_\_\_\_

1st 24 hrs. after shot \_\_\_\_\_

Gas \_\_\_\_\_ Cu. Ft.

Dry Hole \_\_\_\_\_

Abandoned \_\_\_\_\_

Date

DEC 18 1940 19

S. J. LEWIS

Scout

Map No. 47 Sec. 12 Twp. 24 R. 11W

Well No. 7 Stewart

E. H. Moore Company

Contractor

**COMPLETED**

C S L NW SE

990 Ft. from N. Line

\_\_\_\_\_ Ft. from S. Line

\_\_\_\_\_ Ft. from E. Line

660 Ft. from W. Line

**SECTION PLAT**

		o	

ZENITH POOL

Location \_\_\_\_\_

Rig up \_\_\_\_\_

Drilling and Remarks:

*Vidwa 3780*

*5" @ 3718*

*Born & P 5494*

*Map 3000*

*H 2 e ll*

**RECORD**

Cased \_\_\_\_\_ in., \_\_\_\_\_ ft.

Sand \_\_\_\_\_

Gas \_\_\_\_\_

Oil \_\_\_\_\_

Total Depth 3733

**PRODUCTION**

1st 24 hrs. Nat. \_\_\_\_\_

1st 24 hrs. after shot \_\_\_\_\_

Gas \_\_\_\_\_ Cu. Ft.

Dry Hole \_\_\_\_\_

Abandoned \_\_\_\_\_

Date

JAN 15 1941 19

S. J. LEWIS Scout