

KANSAS

Stafford


FORM 51 5M 1-42 PETROL

Section 12 Township 24 Range 11-W

Well No. #7 Tæbar

Company Phillips

NORTH Zenith Pool

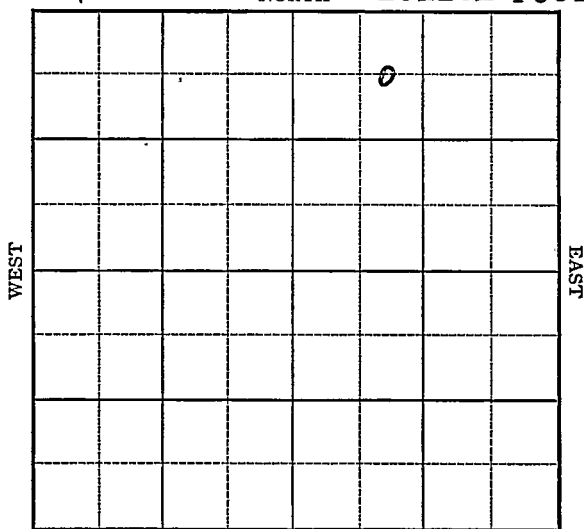


Sec. 12 Twp. 24 R. 11-WWell No. #7 Trebar FarmPhillips Company

(Zenith)

660 Ft. from N. Line Ft. from S. Line Ft. from E. Line990 Ft. from W. Line

Elev. 1803

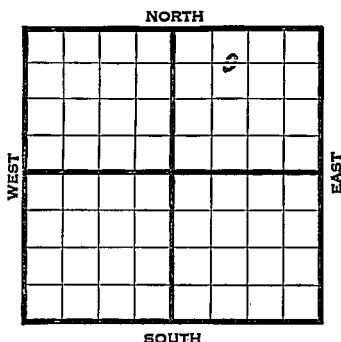

1942	REPORT
4/8	Rotary.
4/15	13" - 73' 8" - 315' Drlg. 1836'
4/22	Drlg. 3333'
4/29	Misener 3670' Viola 3710-18' T.D. 5" - 3711' RUST.
5/6	" " "
5/13	T.D. 3735' 450' oil.
5/20	500 acid. Flow 78 oil & 10% P.B. to 3716' 500 acid.
	Flow 484 oil & 10% water in 14 hours.
5/27	P.B. to 3708' WOC.
6/3	Viola 3710' 5" - 3711' T.D. 3735' P.B. to 3708' Misener 3670' Perf. 3701-06' 500 acid. Bomb potential 2700 oil & 300 water. 41.8 Gravity
	COMPLETED

Stafford

KANSAS


Map No. 47 Sec. 12 Twp. 24 R. 11WWell No. 7 Trebar

Phillips Company

FIRST REPORT

Contractor

SECTION PLAT

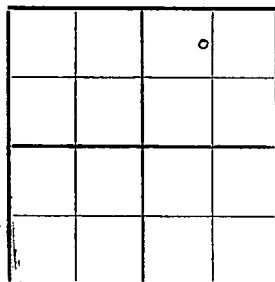

C EL NW NE

660 Ft. from N. Line

Ft. from S. Line

Ft. from E. Line

990 Ft. from W. Line

ZENITH POOL

Location

Rig up

Drilling and Remarks:

Rotary

RECORD

Cased _____ in., _____ ft.

Sand _____

Gas _____

Oil _____

Total Depth _____

PRODUCTION

1st 24 hrs. Nat. _____

1st 24 hrs. after shot _____

Gas _____ Cu. Ft.

Dry Hole _____

Abandoned _____

Date

APR 8 1942 19 S. J. LEWIS Scout

Stafford KANSAS

Map No. 47 Sec. 12 Twp. 24 R. 11WWell No. 7 TretbarPhillips CompanyCOMPLETED Contractor

C E L N W N E

SECTION PLAT

660 Ft. from N. Line Ft. from S. Line Ft. from E. Line990 Ft. from W. Line

ZENITH POOL

Location Rig up

Drilling and Remarks:

Vista 3710
5" @ 3711
PB 3708.
Mine 3670
Prof. 3701-06
500 acd
Bore & P & 2700 oil
+ 300 water

RECORD

Cased in., ft.Sand Gas Oil Total Depth 3725

PRODUCTION

1st 24 hrs. Nat. 1st 24 hrs. after shot Gas Cu. Ft.Dry Hole Abandoned

Date

JUN 3 1942 19S. J. LEWIS Scout