


Section 12 Township 24 Range 12W

Well No. #1 ^McKibben

Company Derby Oil

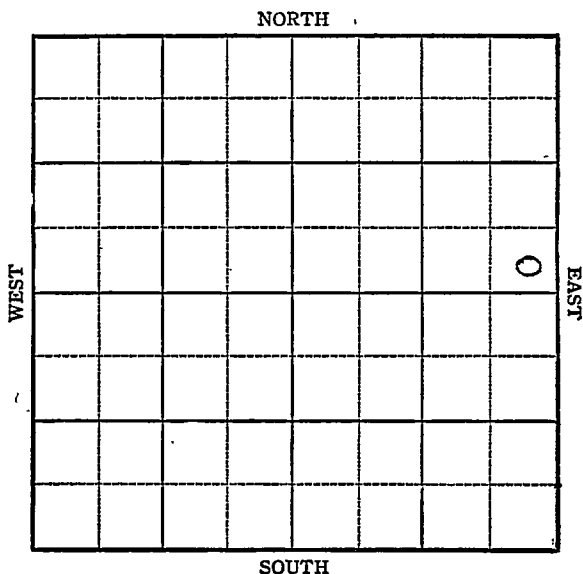

KANSAS

Stafford

Sec. 12 Twp. 24 R. 12W

Well No. #1 McKibben Farm

Derby Oil Company

Wildcat

Ft. from N. Line


330

Ft. from S. Line

330

Ft. from E. Line

Ft. from W. Line

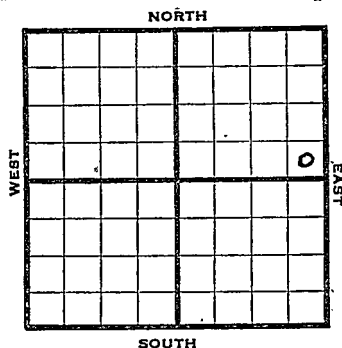

SE NE

REPORT

1944

9/20

Location

9/28

"

10/4

"

10/11

"

10/18

8" @ 325

Drlg. 1475

10/25

Drlg. 3110

11/1

Lans 3414

Drlg. 3650

11/8

Viola 3824

Simp sd 3964

Arb 4001

TD 4008

5" @ 4007 RUST

11/16

" " " "

11/24

" " " "

11/29

12 shots 3828-3820 12 shots

3822-3826 2500 accid Sep 18 oil PH 3
3 hrs.

12/6

" " " " " " " " " "

12/14

" " " " " " " " "

12/21

" " " " " " " "

12/29

" " " " " " " "

1945

1/3

" " " " " " " "

1/10

" " " " " " " "

OVER

1945

1/17

12 shots 3818-26 12 shots
3822-26 2500 acid swb 18 oil
per hr 3 hrs

1/24

Lans 3414
Viola 3824
Arb. 4001
5" @ 4007
Perf. Viola 2500 acid
TD 4008
Pump 290 oil plus 73 water.
Grav. 41.9

COMPLETED

KANSAS

Pool Name WildcatMap No. 49 Sec. 12 Twp. 24 R. 12WWell No. I McKibbenDerby Oil


Company

FIRST REPORT

Contractor

SE¹ NE

SECTION PLAT

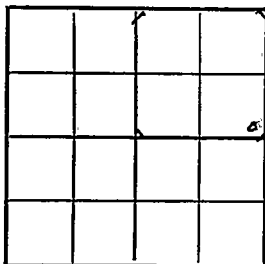 Ft. from N. Line330 Ft. from S. Line330 Ft. from E. Line Ft. from W. Line

Stafford

Location XRig up

Drilling and Remarks: (

RECORD

Cased in., ft.Sand Gas Oil Total Depth

PRODUCTION

1st 24 hrs. Nat. 1st 24 hrs. after shot Gas Cu. Ft.Dry Hole Abandoned

Date

SEP 20 1944

19

S. I. LEWIS

Scout

Pool Name WildcatMap No. K-47 Sec. 12 Twp. 24 R. 12WWell No. 1 McKibbenDerby Oil


Company

COMPLETED

Contractor

SE NE

SECTION PLAT

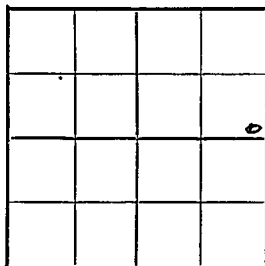 Ft. from N. Line330 Ft. from S. Line330 Ft. from E. Line Ft. from W. LineStaffordLocation Rig up

Drilling and Remarks:

Log 3474Vista 3824Cor 40015" C 4007Perf Vista500 acidPump 29000 + 7000412 g

RECORD

Cased in., ft.Sand Gas Oil Total Depth 4008

PRODUCTION

1st 24 hrs. Nat. 1st 24 hrs. after shot Gas Cu. Ft.Abandoned

Date

JAN 24 1945 19S. J. LEWIS

Scout