

KANSAS


Stafford County

FORM 51 5M PETROL

Section 12 Township 24 Range 12W

Well No. 1 McKibben

Company Plains Exploration

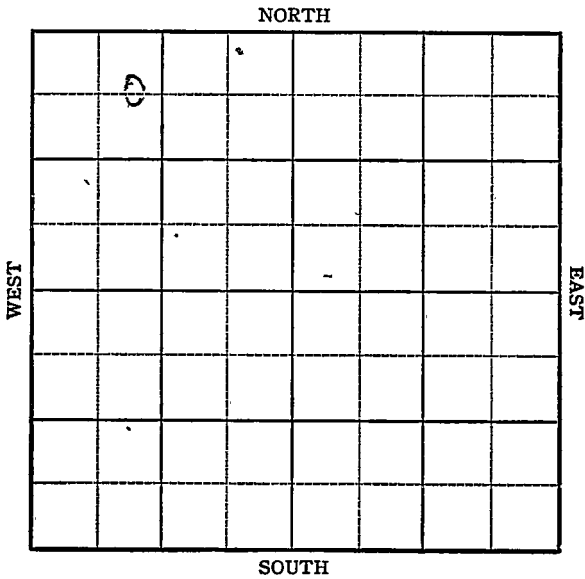

Sec. 12 Twp. 24 R. 12W

Well No. 1 McKibben Farm

Plains Exploration Company


Stafford

660 Ft. from N. Line

_____ Ft. from S. Line

_____ Ft. from E. Line

990 Ft. from W. Line

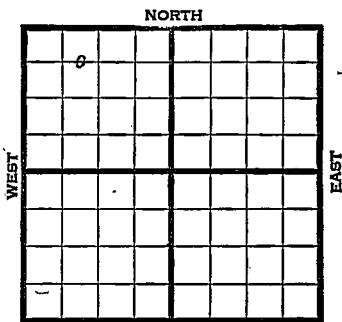

C E L NW ~~NE~~ Elev. 1855

SOUTH

1945

REPORT

5/16	8" -200' WOC
5/24	Drlg. 2610
5/31	Lans 3461
	Drlg. 3510
6/8	Viola 3816 SD TD 3823- 5" @ 3818 RUST
6/20	Viola 3816 5" @ 3818 TD 3876' 500 acid.

ABANDONED

Kansas Pool Name StaffordMap No. 47 Sec. 12 Twp. 24 R. 12WWell No. 1 McKibbenPlains Exploration Company

FIRST REPORT

Contractor

C E L NW NW

SECTION PLAT

660 Ft. from N. Line Ft. from S. Line Ft. from E. Line990 Ft. from W. Line

0			
1			

Stafford

Location _____

Rig up _____

Drilling and Remarks:
8"-200' WOC

RECORD

Cased _____ in., _____ ft.

Sand _____

Gas _____

Oil _____

Total Depth _____

PRODUCTION

1st 24 hrs. Nat. _____

1st 24 hrs. after shot _____

Gas _____ Cu. Ft.

Dry Hole _____

Abandoned _____

Date

MAY 16 1945 19 _____S. J. LEWIS Scout

Kansas Pool Name Stafford

Map No. _____ Sec. 12 Twp. 24 R. 12W

Well No. 1 McKibben

Plains Exploration Company

ABANDONED

Contractor

C E L NW NW

E 11833
SECTION PLAT

660 Ft. from N. Line

_____ Ft. from S. Line

_____ Ft. from E. Line

990 Ft. from W. Line

0			

Stafford County

Location _____

Rig up _____

Drilling and Remarks:

Viola 3716
5" @ 3718
500 acid

RECORD

Cased _____ in. _____ ft.

Sand _____

Gas _____

Oil _____

Total Depth 3876

PRODUCTION

1st 24 hrs. Nat. _____

1st 24 hrs. after shot _____

Gas _____ Cu. Ft.

Dry Hole _____

Abandoned _____

Date

JUN 20 1945 19

S. J. LEWIS Scout