

Company Graybol Contr. Co. & L.B. Smith

WEST

EAST

SOUTH

Stafford KANSAS ✓

Sec. 12 Twp. 24 R. 13 WWell No. # 1 Garner FarmGraybol Contr. Co. & L.B. Smith CompanyGraybol Contractor

Gray Pool


Ft. from N. Line

990 Ft. from S. Line

Ft. from E. Line

330 Ft. from W. Line

NW SW NW

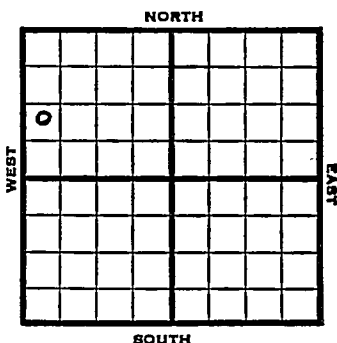

1953

Elev. 1900'

REPORT

5/6
5/21

Location

8" @ 242'

Anhy 740, Top 3024, Heeb 3354, Tor
 3379, Br. L. 3494, Lans 3521,
 DST 3544-99 1 hr, 90' M 810#
 Drlg 3674'

5/27

Spud 5-7-53

D&A

TD 4067

8" @ 242'

Anhy 740, Top 3024, Heeb 3354, Tor
 3379, Br lime 3494, Lans 3521

DST 3544-99, opn 1 hr., rec. 90' mud,
 810#

B KC 3767, Cong 3831, Viola 3846

DST 3850-88, opn 20 mins., rec. 10'
 mud,

Simp 3968


DST 3970-4002, opn 50 mins., rec. 20'
 mud, 60' wcm, 170#

Arb. 4035

TD 4067

D&A

ABANDONED

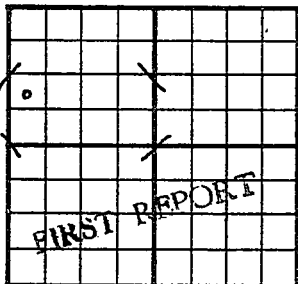County Stafford State KansasSec. 12 (Blk. Twp.) 24 (Sur. Rge.) 13W Map No.Operator Graybol Contr. Co. & L. B. SmithWell No. 1 Farm GarnerElev. _____ Location NW SW NW990 Ft. From S Line NW330 Ft. From W Line Quarter1st. Report MAY 6 1953

Completion _____


Remarks _____

Graybol - Contr.

Spudding Date _____

Drlg. Data Gray PoolLocation

County Stafford State Kansas
 Sec. 12 (Blk. Twp.) 24 (Sur. Rge.) 13W Map No. _____
 Operator Graybol Contr. & L.B. Smith
 Well No. 1 Farm Garner
 Elev. 1900 Location NW SW NW

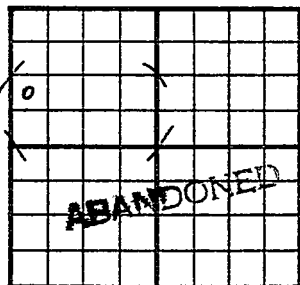

990 Ft. From S Line NW

330 Ft. From W Line Quarter

1st. Report

Completion MAY 27 1953

Remarks Gray Pool

Graybol - Contr.

Spudding Date 5-7-53

Drlg. Data D & A TD 4067

8" @ 242 Anhy 740 Top. 3024

Heeb. 3354 Tor. 3379 Br. lime 3494

Lans. 3521 DST 3544-99 open 1 hr.

Rec. 90' mud 810# B KC 3767

Cong. 3831 Viola 3846 DST 3850-88

open 20 min. Rec. 10' mud Simp. 3968

DST 3970-4002; open 50 min. Rec. 20' mud

60' wcm 170# Arb. 4035 TD 4067

D & A