


Section 12 Township 24 Range 14 W
Well No. 1 Neill Est
Company Lind s Oil et al

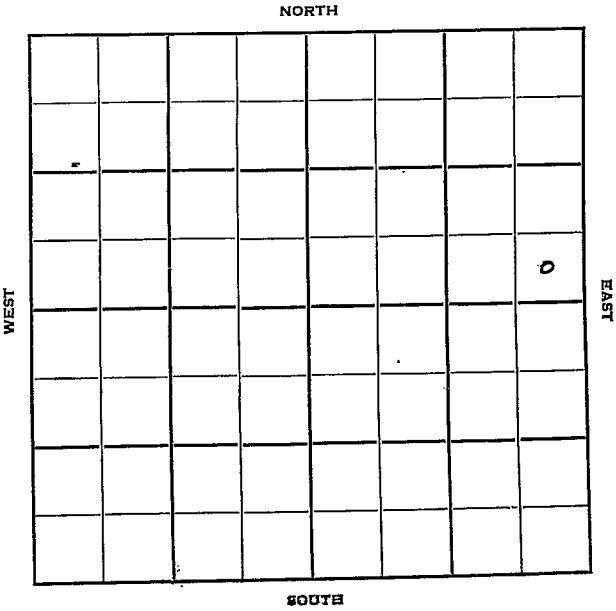

Sec. 12 Twp. 24 R. 14W

Well No. #1 Neill Est. Farm

Lindis Oil et al Company

Contractor


Ft. from N. Line

330' Ft. from S. Line

330' Ft. from E. Line

Ft. from W. Line

SE SE NE

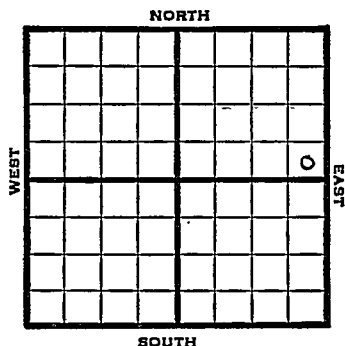

1950	Elev 1913	REPORT
5/17	Spud 5-12-50 12" @ 71' 8" @ 387' Anhy 830-60 Drlg. 916'	
5/31	12" @ 718 TD 4180 Anhy 830-60 Br lime 3551 Lans 3577 DST 3647-55 40 min rec 210' sw Heeb 3421 DST 3716-26 40 min rec 10' mud Viola 3975 Simp 4095 Arb 4146-80 D&A	
	ABANDONED	

KansasMap No. _____ Sec. 12 Twp. 24 R. 14WWell No. 1 Neill Est.Lindis Oil etal Company

Contractor


SE SE NE

_____ Ft. from N. Line

330 Ft. from S. Line330 Ft. from E. Line

_____ Ft. from W. Line

SECTION PLAT

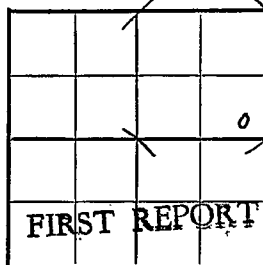Stafford

Location _____

Rig up _____

Drilling and Remarks: _____

Spud. 5-12-50

12 @ 71

8" @ 387

Anhy. 830-60

Drlg. 916

RECORD

Cased _____ in., _____ ft.

Sand _____

Gas _____

Oil _____

Total Depth _____

PRODUCTION

1st 24 hrs. Nat. _____

1st 24 hrs. after shot _____

Gas _____ Cu. Ft.

Dry Hole _____

Abandoned _____

Date

MAY 17 1950

19

J. E. TYRA Scout

Kansas

Map No. _____ Sec. 12 _____ Twp. 24 _____ R. 14W _____


Well No. 1 Neill Est. _____

Lindis Oil et al _____ Company _____

SE SE NE _____ Contractor _____

E1. 1913

SECTION PLAT

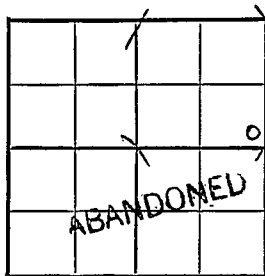

_____ Ft. from N. Line

330 _____ Ft. from S. Line

330 _____ Ft. from E. Line

_____ Ft. from W. Line

Stafford

Location _____

Rig up _____

Drilling and Remarks:

12" C 718
 anky 830-60
 Br line 3551
 Lano. 3577
 DST. 3647-55
 40 min.
 Rec. 210' SW

RECORD

Cased _____ in., _____ ft.

Sand _____

Gas _____

Oil _____

Total Depth 4180

PRODUCTION

1st 24 hrs. Nat. _____

1st 24 hrs. after shot _____

Gas _____ Cu. Ft.

Dry Hole _____

Abandoned _____

Date

OVER

MAY 31 1950 19

J. E. TYRA Scout

Neel. 3421
 DST 3716 - 26
 Rec. 10' mile
 Viola 3975
 Sing. 4088
 arb. 4146 1950
 D + A
 NW

Misc.
 Pierce Map
 France Map
 Tracings
 Land Wall Map
 Land Small Map
 Scout Cards
 80 W

SECT. 17

SECTION

SECTION

SECTION

SECTION

SECTION