


Section 12 Township 24 Range 14-W

Well No. #2 Shell "B"

Company Cities Service

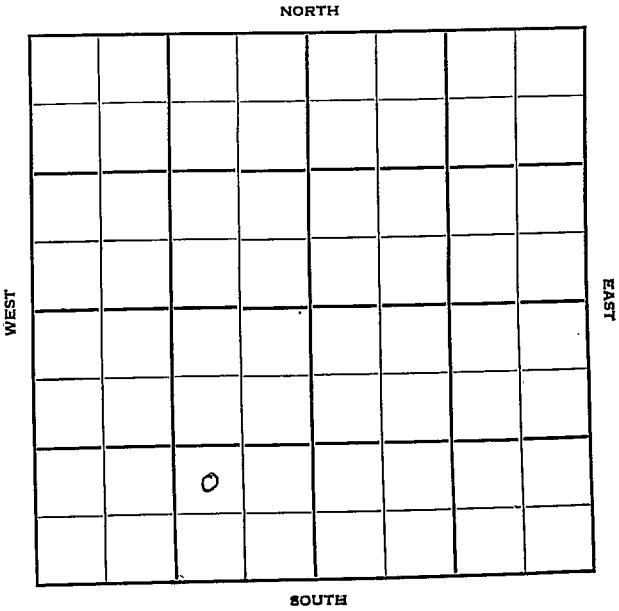

Sec. 12 Twp. 24 R. 14-W ✓

Well No. #2 Shell "B" Farm

Cities Service Company

Contractor

Rattlesnake


_____ Ft. from N. Line

990 Ft. from S. Line

990 Ft. from E. Line

_____ Ft. from W. Line

NW SE SW

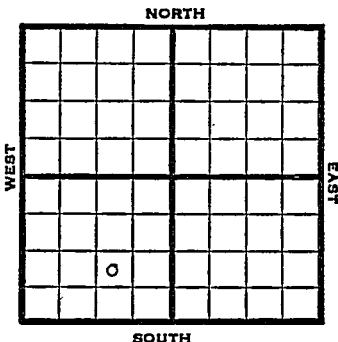

1950

Elev 1917

REPORT

8/2 Location

8/23 Spud 8-9-50

8" @ 368

Lans 3610

DST 3715-30 opn $\frac{1}{2}$ hr rec 7' socm

DST 3751-72 opn $\frac{1}{2}$ hr rec 66' SW

DST 3794-3801 opn $\frac{1}{2}$ hr rec 30' wtr

& SSO

TD 3887

D&A

ABANDONED

Kansas

Rattlesnake Pool

Map No. _____ Sec. 12 Twp. 24 R. 14WWell No. 2 Shell "B"

_____ Cities Service _____ Company

_____ Contractor

NW SE SW

SECTION PLAT

FIRST REPORT

O

_____ Ft. from N. Line

990 Ft. from S. Line990 Ft. from E. Line

_____ Ft. from W. Line

Stafford County

Location X

Rig up _____

Drilling and Remarks:

RECORD

Cased _____ in., _____ ft.

Sand _____

Gas _____

Oil _____

Total Depth _____

PRODUCTION

1st 24 hrs. Nat. _____

1st 24 hrs. after shot _____

Gas _____ Cu. Ft.

Dry Hole _____

Abandoned _____

Date

AUG 2 1950 19

J. E. TYRA

Scout

