

Stafford KANSAS

DX 78-1

Section 12 Township 24 Range 15W


Well No. 1 Devore

Company Greenland Drllg. & NCRA

NORTH

WEST

EAST

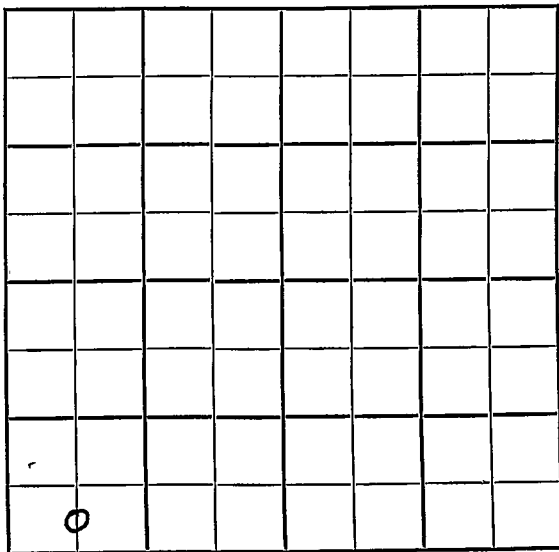

SOUTH

Stafford KANSAS

SEC.	TWP.	R.
12	24	15W

WELL NO.

1 Devore

FARM

COMPANY

Greenland Drlg. & NCRA

CONTRACTOR

Co. tools


E. Macksville Pool

_____ Ft. from N. Line

330 _____ Ft. from S. Line

_____ Ft. from E. Line

660 _____ Ft. from W. Line

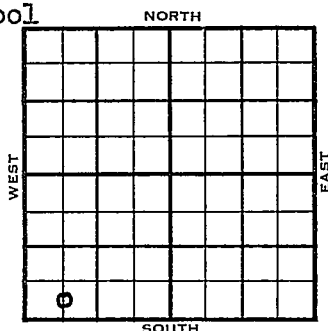

C S $\frac{1}{2}$ S^W SW


	ELEVATION	REPORT
1954	2003'	

7/21 Spdg 7-16-54
8" @ 215
Anhy 942
Drlg. 2540

8/4 Spud 7-16-54 D & A TD 4111
8" @ 215 Anhy 942 Heeb 3521
Br. lime 3662 Lans 3671
Cong. 4034 Viola 4058 Simp 4101
DST 4061-4111 open 1 hr rec 50' mud
1150# TD 4111' D & A

ABANDONED

J. G. McGEHEE

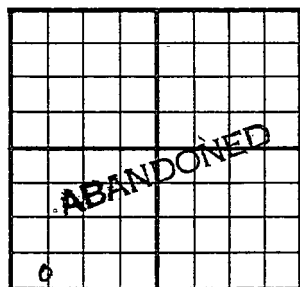County Stafford State KansasSec. 12 (Blk.
Twp.) 24 (Sur.
Rge.) 15W Map No.Operator Greenland Drlg. & NCRAWell No. 1 Farm DevoreElev. 2003 Location C S $\frac{1}{2}$ SW SW330 Ft. From S Line SW660 Ft. From W Line Quarter

1st. Report

Completion AUG 4 1954Remarks E. Macksville PoolCo. toolsSpudding Date 7-16-54Drlg. Data D & A TD 41118" @ 215 Anhy 942 Heeb. 3521Br. lime 3662 Lans. 3671 Cong. 4034Viola 4058 Simp. 4101 DST 4061-4111open 1 hr. Rec. 50' mud 1150#TD 4111D & A

J. G. McGEHEE