

Finney

KANSAS

FORM 51

Section 12 Township 24 Range 33W

Well No. #1 Gardner "A"

Company Northern Pump

NORTH

				0			

WEST

EAST

SOUTH

Finney

KANSAS

SEC.	TWP.	R.
12	24	33 W

WELL NO.

1 Gardner "A"

FARM

COMPANY

Northern Pump

CONTRACTOR

Hugoton Pool


Ft. from N. Line

1260 Ft. from S. Line

Ft. from E. Line

150 Ft. from W. Line

NW SW NE

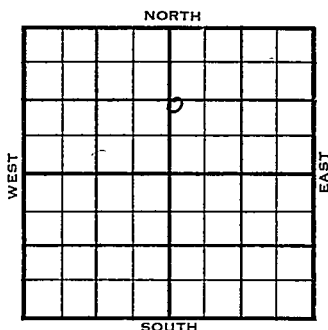

	ELEVATION	REPORT
1954	2847'	
1/20	Spud 1-15-54 10" @ 382	
1/27	Drilg. 980' Hol 2488', Her. 2512', Kr. 2532' Win 2568' RTD 2570' 7" @ 2567'	
2/3	WOCT	
2/24	WOCT	
3/3	CO 2570 6/ 2555-56 sq shale break.	
3/10	Spud 1-15-54 Gas Well TD 2570' 10" @ 382' Hol 2488', Her. 2512', Kri 2532', Win 2568' TD 2570' 7" @ 2567' CO to 2570' 6/2555-56,- DD 2579 96/2518-34, 72/2544-56 Dol-frac Comp. 5,665,000 gas, 3 65#	

County Finner State Kansas

Sec. **12** (Blk. **24** (Sur. **33W** Map No.

Operator Northern Pump

Well No. 1 Farm Gardner "A"

Elev. 2847 Location NW SW NE

0

FIRST REPORT

1260 Ft. From S. Line NE

150 Ft. From W Line Quarter

1st. Report JAN 20 1954

Completion

Remarks

Spudding Date **1-15-54**

Drlg. Data Hugoton Pool

10" @ 382 drlg. 980

J. G. McGEHEE

County Finney State Kansas

Sec. 12 (Blk. Twp.) 24 (Sur. Rge.) 33W Map No.

Operator Northern Pump

Well No. 1 Farm Gardner "A"

Elev. 2847 Location NW SW NE

1260Ft. From S Line NE c

150 Ft. From W Line Quarter

1st. Report

Completion MAR 10 1954

Remarks	Hugoton Pool
---------	--------------

Spudding Date 1-15-54

Drilg. Data Gas well TD 2570

10" @ 382 Hol. 2488 Her. 2512

Kri. 2532 Win. 2568 TD 2570

7" @ 2567 CO to 2570 6/ 2555-56

DD 2579 96/ 2518-34 72/ 2544-56

dol-frac Comp/ 5,665,000 gas 365#

J. G. McGEHEE