


Section 12 Township 24 Range 34W
Well No. #1 Taylor
Company Stanolind

NORTH

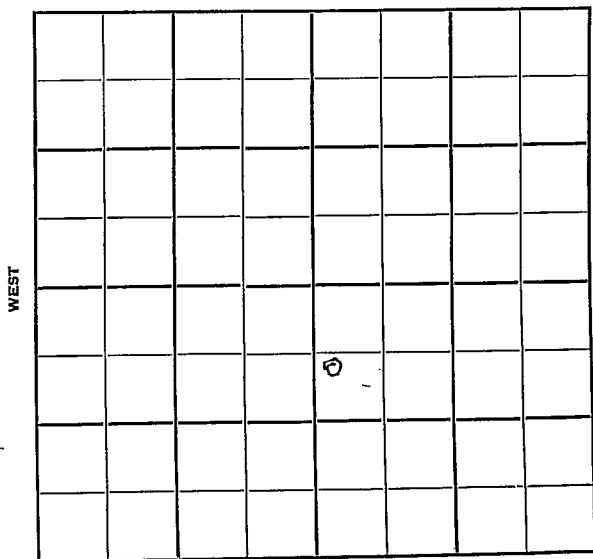

SOUTH

Sec. 12 Twp. 24 R. 34-W ✓

Well No. #1 Taylor Farm

Stanolind Company

Contractor

Hugoton


700 Ft. from N. Line

_____ Ft. from S. Line

_____ Ft. from E. Line

150 Ft. from W. Line

SW NW SE

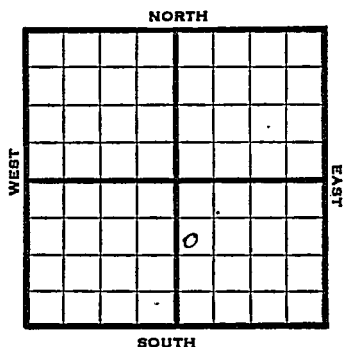

1950 Elev 2883' REPORT

3/22 Location

4/26 T^D 2658'

10 3/4" @ 809'

Herrington 2434-76'

Winfield 2500-20'

Towanda 2555-94'

Ft Riley 2615-58'

7" @ 2622'

168/2434-76

80/2500-20

39/2555-94'

12000 A

24000 A

Comp 4,950,000 Gas open flow

Comp

COMPLETED

Map No. _____ Sec. 12 Twp. 24 R. 34WWell No. 1 Taylor

Stanolind

Company

Contractor


SW NW SE

SECTION PLAT

700 Ft. from N. Line

_____ Ft. from S. Line

_____ Ft. from E. Line

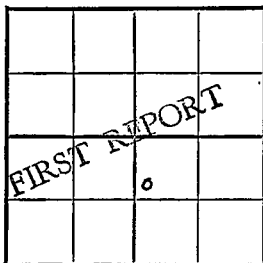150 Ft. from W. Line

Finney County

Location X

Rig up _____

Drilling and Remarks: _____

RECORD

Cased _____ in., _____ ft.

Sand _____

Gas _____

Oil _____

Total Depth _____

PRODUCTION

1st 24 hrs. Nat. _____

1st 24 hrs. after shot _____

Gas _____ Cu. Ft.

Dry Hole _____

Abandoned _____

Date

MAR 22 1933 19

J. E. TYRA

Scout

Kansas

Map No. _____ Sec. 12 Twp. 24 R. 34WWell No. 1 Taylor

Stanolind

Company


Contractor

SW NW SE

E1. 2883
SECTION PLAT700 Ft. from N. Line

_____ Ft. from S. Line

_____ Ft. from E. Line

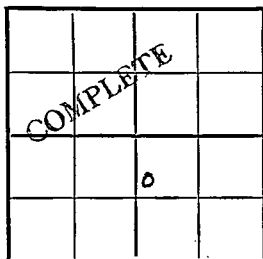150 Ft. from W. Line

Finney County

Location _____

Rig up _____

Drilling and Remarks:

10 3/4" e 809
 Herington 2434-76
 Winfield 2500-20
 Towanda 2555-94
 Ft Riley 2615-58
 7" e 1 2622
 168/2434-76

RECORD

Cased _____ in., _____ ft.

Sand _____

Gas _____

Oil _____

Total Depth 2658

PRODUCTION

1st 24 hrs. Nat. _____

1st 24 hrs. after shot _____

Gas _____ Cu. Ft.

Dry Hole _____

Abandoned _____

Date

APR 26 1950 19

J. E. TYRA Scout

80/ 2500-20
39/ 2555-94

12000 A

24000 A

Comp. 4, 950, 000 gas, open flow

Scout Cards
Land Small Map
Land Wall Map
Tracings
France Map
Pierce Map
Misc.

[Signature]

THE AIR









