


28-24-13W

WELL LOG BUREAU—KANSAS GEOLOGICAL SOCIETY  
508 East Murdock, Wichita, Kansas

Company. ARTNELL COMPANY  
Farm. C. Toland No. 2

SEC. 28 T. 24 R. 13W  
NW NE NW

Total Depth. 4180'  
Comm. 10-29-53 Comp. 11-13-58  
Shot or Treated.  
Contractor. Leben Drilg.  
Issued. 1-31-59

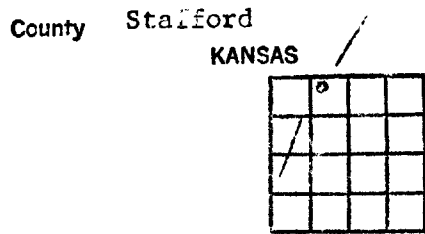

Elevation. 1930' RB

Production. Dry

CASING:

3 5/8" 807' cem w/575 sx.

Figures indicate Bottom of Formations.

surface clay	15
sand	105
shale & shells	222
sand & redbed	415
redbed	800
Anhydrite	832
redbed & shells	1050
shale	1230
shale, shells & sand	1600
shale & lime	1795
lime	2195
lime & shale	3090
shale & lime	3604
lime	4180
Total Depth	

TOPS:

Heebner	3436
Toronto	3454
Brown Lime	3573
Kansas City	3601
Base Kansas City	3969
Cherty Conglomerate	3934
Viola	3986
Simpson Shale	4123
Simpson Sand	4141
Arbuckle	4175

DST #1 3795-3811, tool op 90 mins.  
rec. 36' slightly oil specked mud,  
ISIP 0#/20 mins., FBHP 0#/20 mins.  
IFP 0#, FFP 0#.

DST #2 3825-3845, tool op 90 mins.  
rec. 38' slightly oil specked mud.  
ISIP 1600#/20 mins., (Tool slid, false  
pressure) FBHP 0#/20 mins., IFP 0#,  
FFP 0#.

DST #3 4158-4178, tool op 90 mins.  
Rec. 6' mud, all pressures 0#.