


TWP. 24^S RGE. 13^W COUNTY STAFFORD STATE KANSAS

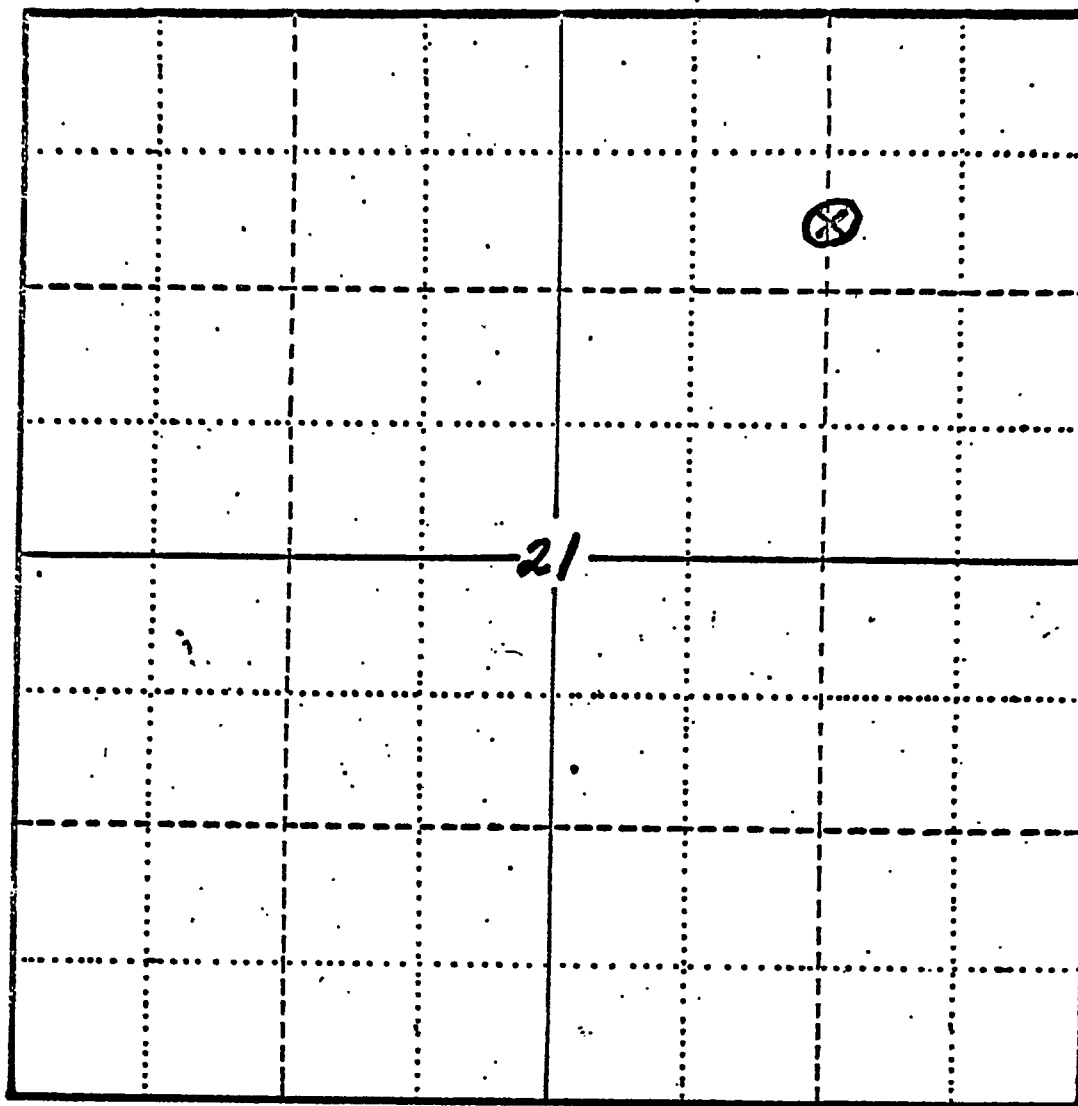

Legal Description 5/2 N/2 NE/4

COMPANY ASPEN DRILLING Co.

LEASE NAME OWEN

WELL NO. 1

990 Ft. from NORTH Line
1320 Ft. from EAST Line

of NE Quarter of Section 21-24^S-13^W

790' 0.51"