

Sec. 13 Twp. 24 R. 5W


Well No. 1 Baugham Farm

B & R et al

Company

B & R et al Contr. Burrton Pool

NORTH

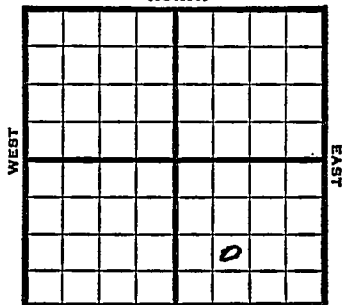

_____ Ft. from N. Line

990 Ft. from S. Line

_____ Ft. from E. Line

990 Ft. from W. Line

NE SW SE

SOUTH

1949

Elev 1476'

REPORT

7/27

Drlg 3125'

8/3

Miss 3339'

TD 3362'

5" @ 3354'

8/10

TD 3406'

4" Perf liner @ 3406

8/17

"

8/24

"

8/31

"

9/7

"

9/14

TD 3406'

Miss 3339'

Aband.

ABANDONED

Kansas

Burrton Pool

Map No. _____ Sec. 13 Twp. 24 R. 5W

Well No. 1 Baugham

B & R etal.

Company

B & R etal.

Contractor

**FIRST REPORT
SECTION PLAT**

NE SW SE

			o

_____ Ft. from N. Line

990 Ft. from S. Line

_____ Ft. from E. Line

990 Ft. from W. Line

Beane County

Location _____

Rig up _____

Drilling and Remarks:

3125

RECORD

Cased _____ in., _____ ft.

Sand _____

Gas _____

Oil _____

Total Depth _____

PRODUCTION

1st 24 hrs. Nat. _____

1st 24 hrs. after shot _____

Gas _____ Cu. Ft.

Dry Hole _____

Abandoned _____

Date

JUL 27 1949 19

S. J. LEWIS Scout

