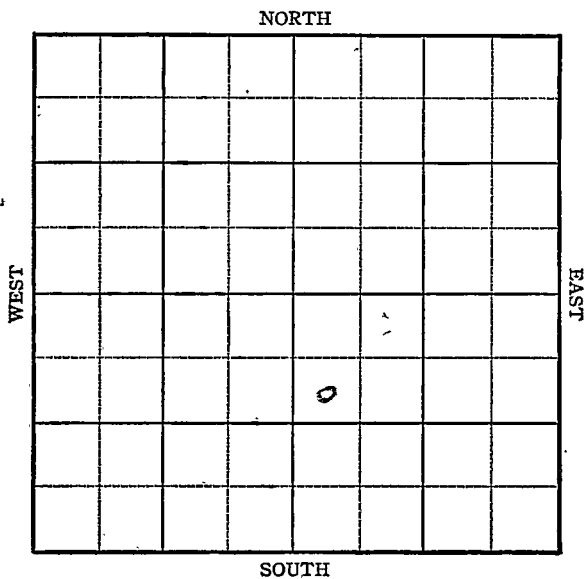


KANSAS

Reno

FORM 51 5M PETROL

Section 13 Township 24 Range 8WWell No. 4 Love EstateCompany H. A. Hershfield etal

KANSAS

Reno

Sec. 13 Twp. 24 R. 8-W

Well No. #4 Love Estate Farm


H. A. Hershfield et al Company

990 Ft. from N. Line

Ft. from S. Line

Ft. from E. Line

330 Ft. from W. Line

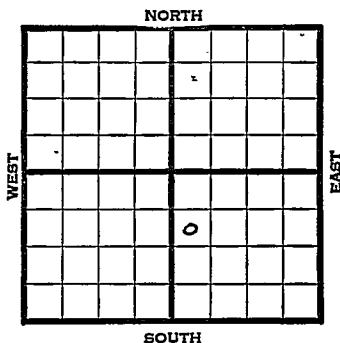

SW NW SE Elev. 1628

1945

R E P O R T

8/22

RUR

8/29

10" @ 205 WOC

9/5

Anhy 360

Drig. 2465

9/12

Lans 3177

Drig. 3361

9/19

Lans. 3177


TD 3560!

ABANDONED

KANSAS
~~Kansas~~Pool Name AbbeyvilleMap No. 41 Sec. 13 Twp. 24 R. 8WWell No. 4 Love EstateH. A. Hershfield etal Company**FIRST REPORT**

Contractor

SW NW. SE

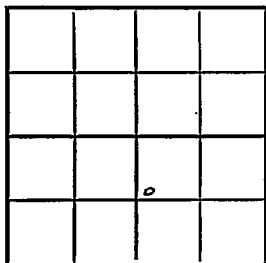SECTION PLAT990 Ft. from N. Line Ft. from S. Line Ft. from E. Line330 Ft. from W. Line

Reno County

Location Rig up Drilling and Remarks:
RUK**RECORD**Cased in., ft.Sand Gas Oil Total Depth **PRODUCTION**1st 24 hrs. Nat. 1st 24 hrs. after shot Gas Cu. Ft.Dry Hole Abandoned

Date

AUG 22 1945

19

S. J. LEWIS.

Scout


KANSAS

Kansas

Pool Name AbbeyvilleMap No. 41 Sec. 13 Twp. 24 R. 8WWell No. 4 Love EstateH. A. Hershfield etal CompanyABANDONED

Contractor

SW NW SE

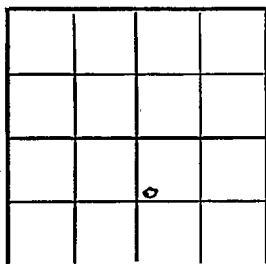E1/628
SECTION PLAT990 Ft. from N. Line Ft. from S. Line Ft. from E. Line330 Ft. from W. Line

Reno County

Location Rig up

Drilling and Remarks:

Leans 8/77

RECORD

Cased in., ft.Sand Gas Oil Total Depth 3560

PRODUCTION

1st 24 hrs. Nat. 1st 24 hrs. after shot Gas Cu. Ft.Dry Hole Abandoned

Date

SEP 19 1945

19

S. J. LEWIS

Scout