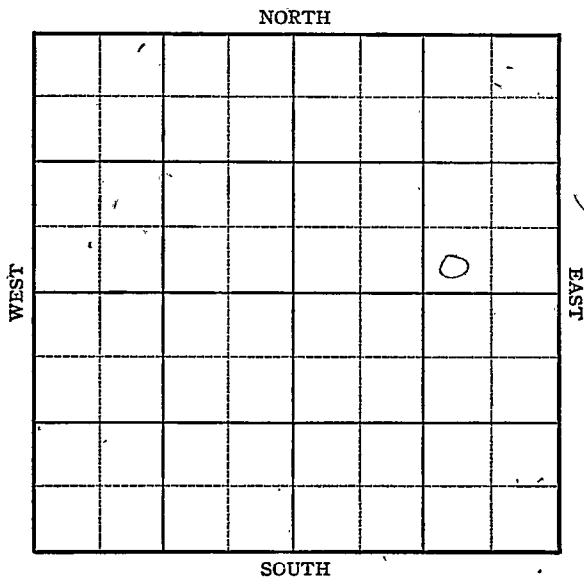


Reno County

KANSAS

Section 13 Township 24 Range 8WWell No. #5 Love EstateCompany H. Hershfield

KANSAS

Reno County

Sec. 13 Twp. 24 R. 8WWell No. #5 Love Estate FarmH. Hershfield Company

Abbyville

Ft. from N. Line

330


Ft. from S. Line

990

Ft. from E. Line

Ft. from W. Line

NORTH

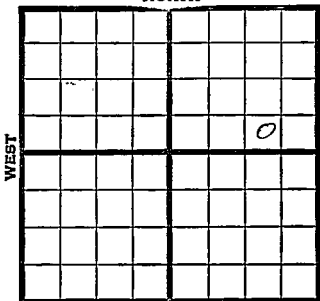

SOUTH

SW SE NE

Elev. 1628'

REPORT

1945

3/28 Location
 4/5 RUR
 4/12 10" @ 80' WOC
 4/20 Drlg. 2080'
 4/27 Drlg. 2936
 5/9 Lans 3164
 TD 3551'

ABANDONED

Pool Name AbbyvilleMap No. 41 Sec. 13 Twp. 24 R. 8WWell No. 5 Love EstateH. Hershfield

Company

FIRST REPORT

Contractor

SW SE NE

SECTION PLAT

			o

 Ft. from N. Line330 Ft. from S. Line990 Ft. from E. Line Ft. from W. LineRenoLocation XRig up Drilling and Remarks:

RECORD

Cased in., ft.Sand Gas Oil Total Depth

PRODUCTION

1st 24 hrs. Nat. 1st 24 hrs. after shot Gas Cu. Ft.Dry Hole Abandoned

Date

MAR 28 1945 19S. I. LEWIS Scout


Kansas Pool Name AbbyvilleMap No. 41 Sec. 13 Twp. 24 R. 8WWell No. 5 Love EstateH. Hershfield

Company

ABANDONED

Contractor

SW SE NE

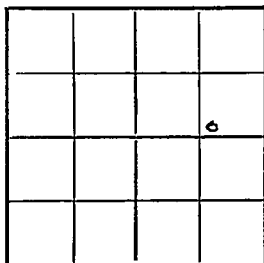E1/1628
SECTION PLAT Ft. from N. Line330 Ft. from S. Line990 Ft. from E. Line Ft. from W. Line

Reno County

Location Rig up

Drilling and Remarks:

Lane 3/64

RECORD

Cased: in., ft.Sand Gas Oil Total Depth 3551

PRODUCTION

1st 24 hrs. Nat. 1st 24 hrs. after shot Gas Cu. Ft.Dry Hole Abandoned

Date

MAY 9 1945 19

S. J. LEWIS Scout