


Section 13 Township 24 Range 11-W

Well No. #5 Opal Hartnett

Company Stanolind

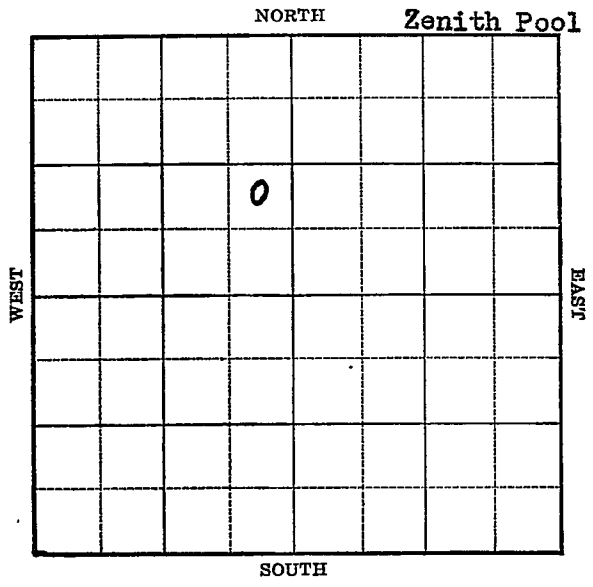

Stafford **KANSAS**Map No. 47 Sec. 13 Twp. 24 R. 11WWell No. 5 Opal HartnettStanolind Company

Contractor

FIRST REPORT**NE SE NW**

_____ Ft. from N. Line

990 Ft. from S. Line330 Ft. from E. Line

_____ Ft. from W. Line

SECTION PLAT

	0		

ZENITH POOL

Location _____

Rig up _____

Drilling and Remarks:

RUR**RECORD**

Cased _____ in., _____ ft.

Sand _____

Gas _____

Oil _____

Total Depth _____

PRODUCTION

1st 24 hrs. Nat. _____

1st 24 hrs. after shot _____

Gas _____ Cu. Ft.

Dry Hole _____

Abandoned _____

Date

JAN 4 - 1938 19H. D. Hatfield Scout

Stafford **KANSAS**

Map No. _____ Sec. 15 Twp. 24 R. 11W

Well No. 5 Opal Hartnett

Stanolind Company

Contractor

COMPLETED

SECTION PLAT

NE SE NW

_____ Ft. from N. Line

990 Ft. from S. Line

330 Ft. from E. Line

_____ Ft. from W. Line

ZENITH POOL

	o		

Location _____

Rig up _____

Drilling and Remarks:

Rot 664

RECORD

Cased 7 in. 3773 ft.

Sand Misener 3772

Gas _____

Oil _____

Total Depth 3791 (in Sand)

PRODUCTION

1st 24 hrs. Nat. _____

1st 24 hrs. after shot _____

Gas _____ Cu. Ft.

Dry Hole _____

Abandoned _____

Date FEB 8 1939

H.D.H.
By Paul Scout