


Section 13 Township 24 Range 11-W

Well No. #4 M. W. Johnson

Company E. H. Moore

NORTH Zenith Pool

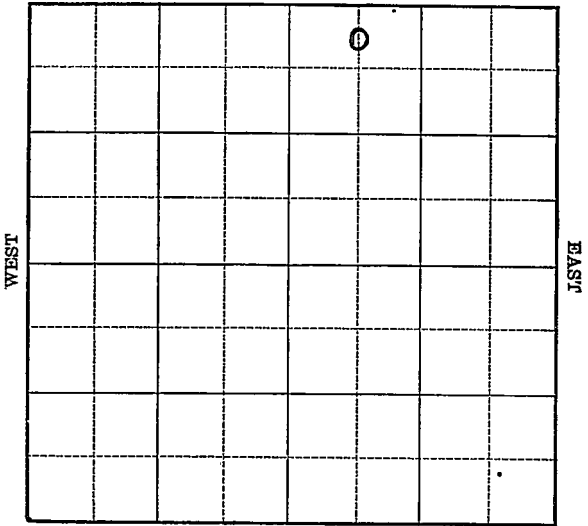

SOUTH

Map No. 47 Sec. 13 Twp. 24 R. 11WWell No. 4 M. W. JohnsonE. H. Moore

Company

Contractor

FIRST REPORT**SECTION PLAT**C $N\frac{1}{2}$ NW NE
330 Ft. from N. Line Ft. from S. Line Ft. from E. Line660 Ft. from W. Line

		o	

ZENITH POOLLocation Rig up

Drilling and Remarks:

Ponds**RECORD**Cased in., ft.Sand Gas Oil Total Depth **PRODUCTION**1st 24 hrs. Nat. 1st 24 hrs. after shot Gas Cu. Ft.Dry Hole Abandoned

Date

AUG 9 1939 19S. J. LEWIS Scout

Stafford **KANSAS**Map No. _____ Sec. **13** Twp. **24** R. **11W**Well No. **4 M. W. Johnson****E. H. Moore**

Company

Contractor

COMPLETE**C N $\frac{1}{2}$ NW NE****330** Ft. from N. Line

Ft. from S. Line

Ft. from E. Line

660 Ft. from W. Line**SECTION PLAT**

		C	

ZENITH POOL

Location _____

Rig up _____

Drilling and Remarks:

*Mainer 3755**7" @ 3756.**Vista 3751**Bottom Hole Bone**6331 28.**Maximum 2500***RECORD**

Cased _____ in., _____ ft.

Sand _____

Gas _____

Oil _____

Total Depth **2276****PRODUCTION**

1st 24 hrs. Nat. _____

1st 24 hrs. after shot _____

Gas _____ Cu. Ft.

Dry Hole _____

Abandoned _____

Date

SEP 20 1939**S. J. LEWIS** Scout