


Section 13 Township 24 Range 11-NWell No. #6 J. K. JohnsonCompany E. H. Moore, Inc.

NORTH

Zenith Pool

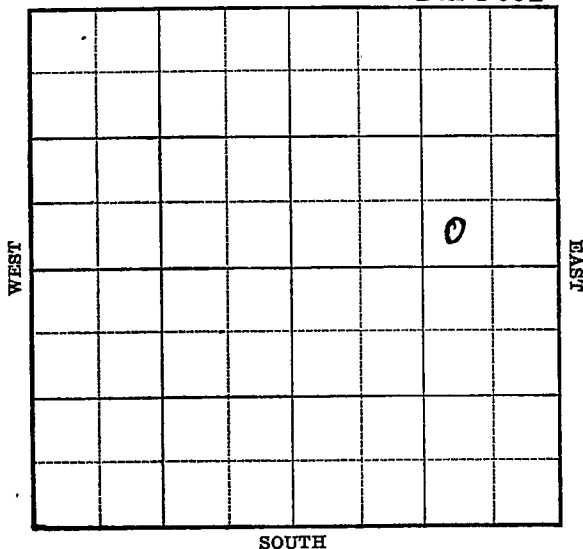

Stafford **KANSAS**Map No. 47 Sec. 13 Twp. 24 R. 11WWell No. 6 J. K. JohnsonE. H. Moore Inc. CompanyFIRST REPORT Contractor**SW SE NE** Ft. from N. Line330 Ft. from S. Line990 Ft. from E. Line Ft. from W. Line**SECTION PLAT**

			0

ZENITH POOLLocation Rig up

Drilling and Remarks:

CELLAR**RECORD**Cased in., ft.Sand Gas Oil Total Depth **PRODUCTION**1st 24 hrs. Nat. 1st 24 hrs. after shot Gas Cu. Ft.Dry Hole Abandoned

Date

JAN 4 - 1937 19 H. D. Hatfield Scout

Stafford KANSAS

Map No. _____ Sec. 13 Twp. 24 R. 11WWell No. 6 J. K. JohnsonE. H. Moore Inc. Company

Contractor

COMPLETED

SW SE NE

 Ft. from N. Line330 Ft. from S. Line990 Ft. from E. Line Ft. from W. Line

ZENITH POOL

SECTION PLAT

			0

Location _____

Rig up _____

Drilling and Remarks:

Pot 3509

RECORD

Cased 7 in., 3779 ft.Sand Misener 3783Gas 11012 3794 (Dry)

Oil _____

Total Depth. 3795

PRODUCTION

1st 24 hrs. Nat. _____

1st 24 hrs. after shot _____

Gas _____ Cu. Ft.

Dry Hole _____

Abandoned _____

Date

FEB 8 1939 19

H.D.H.

Scout

Reg. Prof.