


Section 13 Township 24 Range 11-W

Well No. #3 Cleo Johnson

Company E. H. Moore



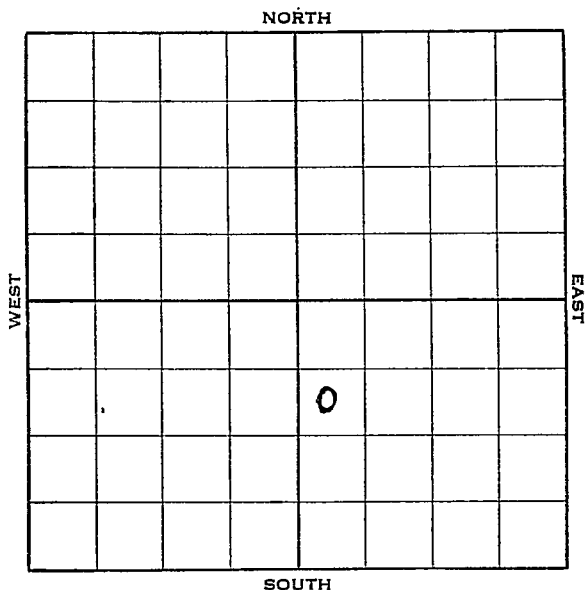

Stafford **KANSAS**Map No. 47 Sec. 13 Twp. 24 R. 11WWell No. 3 Cleo JohnsonE. H. Moore Company

Contractor

**FIRST REPORT****SECTION PLAT**990 SW NW SE  
Ft. from N. Line

\_\_\_\_ Ft. from S. Line

\_\_\_\_ Ft. from E. Line

330 \_\_\_\_\_  
Ft. from W. Line

		0	

Location \_\_\_\_\_

Rig up \_\_\_\_\_

Drilling and Remarks:

10" - 263

W00

**RECORD**

Cased \_\_\_\_\_ in., \_\_\_\_\_ ft.

Sand \_\_\_\_\_

Gas \_\_\_\_\_

Oil \_\_\_\_\_

Total Depth \_\_\_\_\_

**PRODUCTION**

1st 24 hrs. Nat. \_\_\_\_\_

1st 24 hrs. after shot \_\_\_\_\_

Gas \_\_\_\_\_ Cu. Ft.

Dry Hole \_\_\_\_\_

Abandoned \_\_\_\_\_

Date

NOV 2 - 1938

19

H. D. Hatfield Scout

Stafford **KANSAS**Map No. 47 Sec. 13 Twp. 24 R. 11WWell No. 3 Cleo JohnsonE. H. Moore

Company

Contractor

**COMPLETED****SECTION PLAT**990 SW NW SE  
Ft. from N. Line

Ft. from S. Line

Ft. from E. Line

330 Ft. from W. Line

		0	

Location \_\_\_\_\_

Rig up \_\_\_\_\_

Drilling and Remarks:

POT 2790Flow**RECORD**Cased 7 in., 3790 ft.Sand Misener 3789

Gas \_\_\_\_\_

Oil \_\_\_\_\_

Total Depth 3808**PRODUCTION**

1st 24 hrs. Nat. \_\_\_\_\_

1st 24 hrs. after shot \_\_\_\_\_

Gas \_\_\_\_\_ Cu. Ft.

Dry Hole \_\_\_\_\_

Abandoned \_\_\_\_\_

Date

DEC 7 - 1938

19

H. D. Hatfield

Scout