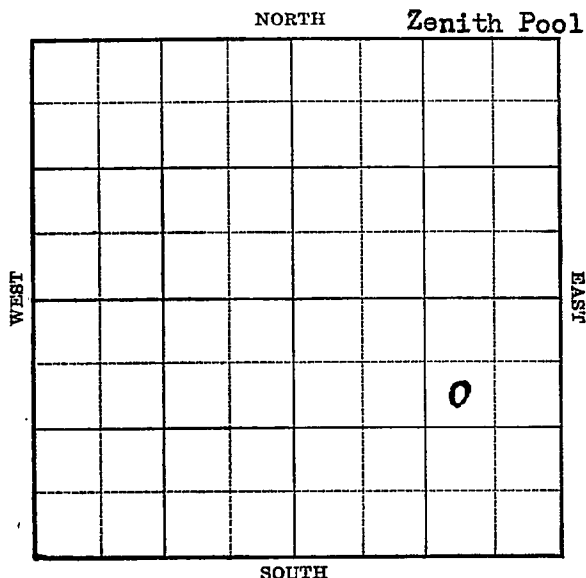


Section 13 Township 24 Range 11-WWell No. #10 Cleo JohnsonCompany E. H. Moore, Inc.

Stafford KANSAS

Map No. 47 Sec. 13 Twp. 24 R. 11WWell No. 10 Cleo JohnsonE. H. Moore, INC. Company

Contractor

FIRST REPORT
SW NE SE

SECTION PLAT

			O

990 Ft. from N. Line Ft. from S. Line990 Ft. from E. Line Ft. from W. Line

ZENITH POOL

Location Rig up

Drilling and Remarks:

RR

RECORD

Cased in., ft.Sand Gas Oil Total Depth

PRODUCTION

1st 24 hrs. Nat. 1st 24 hrs. after shot Gas Cu. Ft.Dry Hole Abandoned

Date

DEC 28 1938 19

H. D. Hatfield Scout

Stafford

KANSAS

Map No. _____ Sec. 13 Twp. 24 R. 11WWell No. 10 Cleo JohnsonE. H. Moore Inc.

Company

Contractor

COMPLETED

SW NE SE

990 Ft. from N. Line

_____ Ft. from S. Line

990 Ft. from E. Line

_____ Ft. from W. Line

ZENITH POOL

SECTION PLAT

			0

Location _____

Rig up _____

Drilling and Remarks: *P.B. 3811**POT 46*

RECORD

Cased _____ in., _____ ft.

Sand *Misener 3802*Gas *110/2 3813 (Dry)*

Oil _____

Total Depth *3814*

PRODUCTION

1st 24 hrs. Nat. _____

1st 24 hrs. after shot _____

Gas _____ Cu. Ft.

Dry Hole _____

Abandoned _____

Date

FEB 8 1939

19

H. D. H.

Scout

Boy Paul